IREDELL COUNTY HEALTH DEPARTMENT

Statesville Office (704) 878-5305 Mooresville Office (704) 660-3625 PERMIT # 210617

IMPROVEMENT PERMIT / AUTHORIZATION TO CONSTRUCT / OPERATION PERMIT / EXISTING SYSTEM

PIN # 4637-06-3878.000

APPLICANT: Kenneth Teeter APPLICANT ADDRESS: 161 Ridgetop Rd. Mooresville NC

SITE ADDRESS: 161 Ridgetop Rd. Mooresville NC PHONE: 704-779-7634 ALT. PHONE:

SITE DIRECTIONS: Hwy 150 West, R Quiet Cove, R Ridgetop

SUBDIVISION: Spring Acres SECTION: 3 LOT # 55 LOT AREA: .960 Acre DESIGN FLOW: 480 GPD L.T.A.R.: Existing .3

Septic Tank Existing (gal) STB Date
Pump Tank Existing (gal) PT Date
Pump Make Existing Model Existing Serial # Existing
Nitrification Fields Ex. # Lines Existing 4 Linear Ft: Existing
Trench Width Existing Max. Trench Bottom Depth Existing Gravel Depth Existing (N/A)


☐ New System ☐ Repair ☐ Expansion System Type: I II (III) IV V VI
System Description: Existing 25% Reduction - Pump
Repair System Description: Existing
Maintenance Agreement Required: ☐ YES ☒ NO
☐ GRAVITY ☒ PRESSURE

☒ Residence No. Bedrooms Ex. 4
☐ Business No. Persons Ex. 8
☐ Other No. Employees
☐ Slab ☐ Crawl Space
☒ Basement w/plumbing ☐ Basement w/o plumbing


Water Supply: ☒ Private ☐ Public ☐ Community

Comments / Conditions: Maintain 5' Seperation From Deck Addition And Septic Tanks.

INITIAL SITE SKETCH

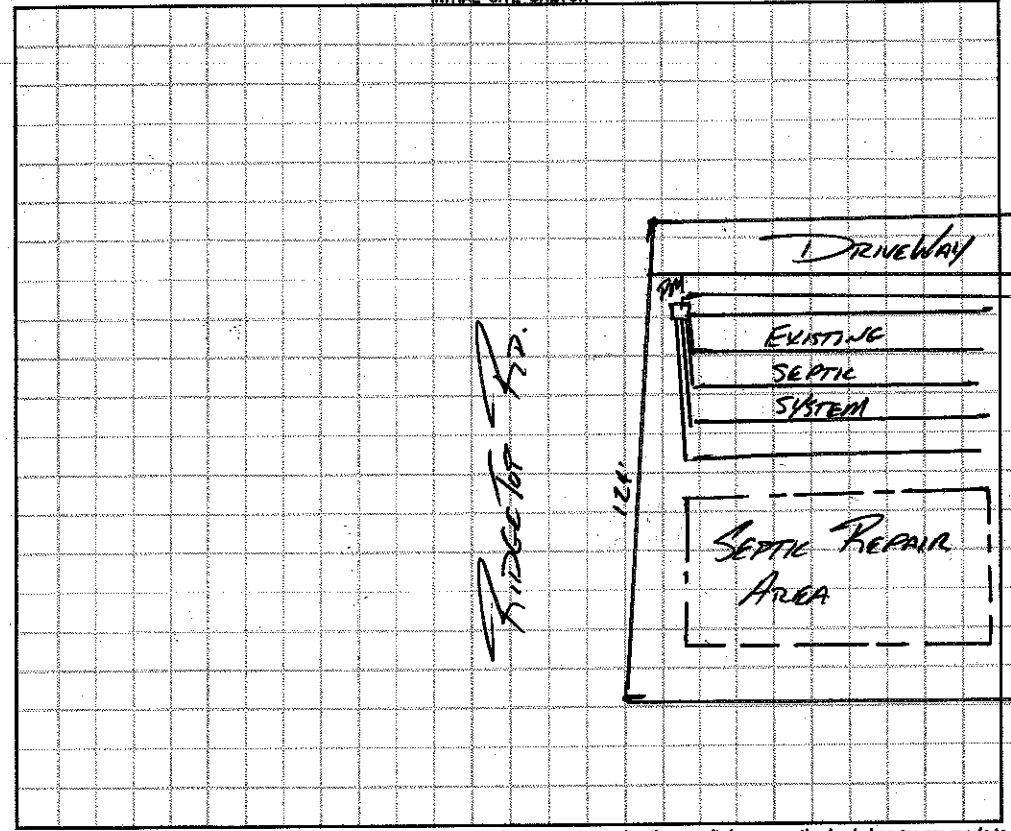

AS BUILT SKETCH

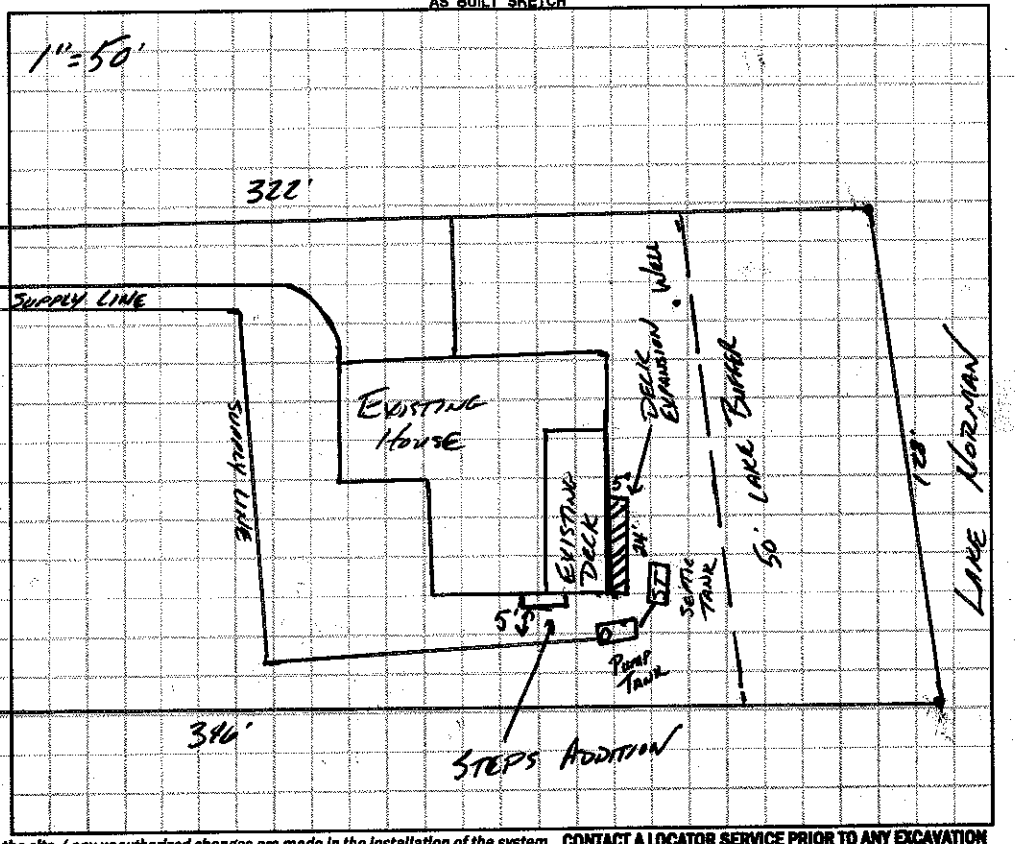

Permit can be suspended or revoked if any false information is supplied toward securing the permit / any unauthorized changes are made to the site / any unauthorized changes are made in the installation of the system. **CONTACT A LOCATOR SERVICE PRIOR TO ANY EXCAVATION**

☐ **IMPROVEMENT PERMIT** *with plat valid without expiration.* ☐ **IMPROVEMENT PERMIT** *with site plan valid for 60 mos.* ☐ **AUTHORIZATION TO CONSTRUCT** *valid for period equal to IMPROVEMENT PERMIT--not to exceed 60 mo.*

Owner / Applicant Signature: Date: 6/17/2015 Installed by:

IMPROVEMENT PERMIT by: Date: OPERATION PERMIT by: Date:

AUTHORIZATION TO CONSTRUCT by: Date: Existing System Inspected by: APPROVED Date: JUN 15 2015

Health Dept. Copy - WHITE Applicant (Final Approval) - YELLOW Applicant (Conditional Approval) - PINK