IREDELL COUNTY HEALTH DEPARTMENT

Statesville Office (704) 878-5305 Mooresville Office (704) 660-3625 PERMIT # 208082

IMPROVEMENT PERMIT / AUTHORIZATION TO CONSTRUCT / OPERATION PERMIT / EXISTING SYSTEM

PIN # 4637-06-4691

APPLICANT: Lisa Wine APPLICANT ADDRESS: 130 Landings Dr # 411

SITE ADDRESS: 496 Greenbay Rd - Mooresville PHONE: 972-795-0908 ALT. PHONE:

SITE DIRECTIONS: 150W, TL on Quiet Cove, TR on Ridgetop, Lot on L@ corner of Ridgetop and Greenbay Rd


SUBDIVISION: CL&T SECTION: 10 LOT # 96 LOT AREA: 1.15ac DESIGN FLOW: L.T.A.R.:

Septic Tank	1500	(gal)	STB	444	Date	11-18-15	☑ New System	☐ Repair	☐ Expansion	System Type: I II III IV V VI	☑ Residence	No. Bedrooms	5	Water Supply
Pump Tank	1500	(gal)	PT	477	Date	11-11-15	System Description:	LP PPBPS			☐ Business	No. Persons	10	☑ Private
Pump Make	Goulds	Model	WE0S 1ZHHU		Serial #		Repair System Description:	TS11 Drip Irrigation			☐ Other	No. Employees		☐ Public
# Nitrification Fields	1	# Lines	6		Linear Ft:	335'	Maintenance Agreement Required:	☑ YES	☐ NO		☐ Slab	☑ Crawl Space		☐ Community
Trench Width	24" min	Max. Trench Bottom Depth	36"		Gravel Depth	N/A		☐ GRAVITY	☑ PRESSURE		☐ Basement w/plumbing		☐ Basement w/o plumbing	

Comments / Conditions: This permit replaces Permit Dated 4-10-15, The purpose of this permit is to move the Septic and Pump tank into existing septic bed area.

CHECKED TANKS 12-21-15
CHECKED LINES RA
SET 2' PM 1-7-16
CHECKED ELEC. RA

INITIAL SITE SKETCH

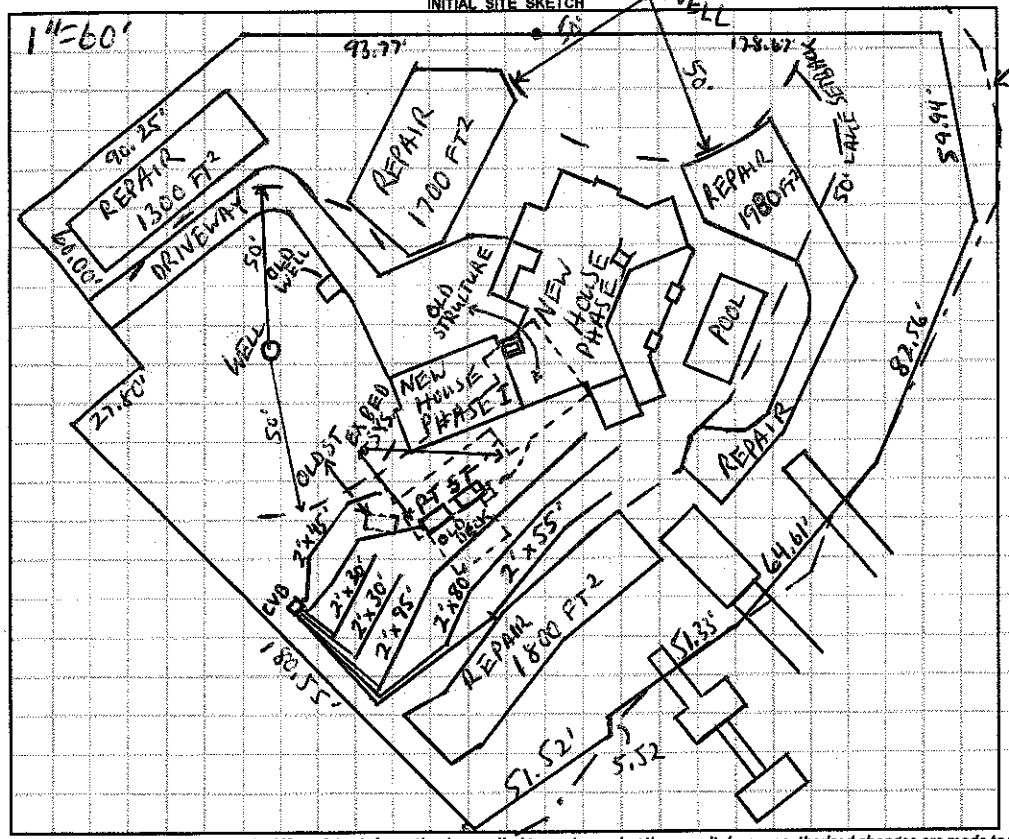

AS BUILT SKETCH

Permit can be suspended or revoked if any false information is supplied toward securing the permit / any unauthorized changes are made to the site / any unauthorized changes are made in the installation of the system. **CONTACT A LOCATOR SERVICE PRIOR TO ANY EXCAVATION**

☐ **IMPROVEMENT PERMIT** *with plat valid without expiration.* ☑ **IMPROVEMENT PERMIT** *with site plan valid for 60 mos.* ☑ **AUTHORIZATION TO CONSTRUCT** *valid for period equal to IMPROVEMENT PERMIT--not to exceed 60 mo.*

Owner / Applicant Signature: Lisa Wine Date: 7-2-15 Installed by: FJ ERVIN

IMPROVEMENT PERMIT by: Date: 7-1-15 OPERATION PERMIT by: RA Date: 1-14-16

AUTHORIZATION TO CONSTRUCT by: Date: 7-1-15 Existing System Inspected by: Date:

Health Dept. Copy - WHITE Applicant (Final Approval) - YELLOW Applicant (Conditional Approval) - PINK