IREDELL COUNTY HEALTH DEPARTMENT

STATESVILLE 704-878-5305 MOORESVILLE 704-664-5281

IMPROVEMENT PERMIT / AUTHORIZATION TO CONSTRUCT / OPERATION PERMIT / EXISTING SYSTEM INSPECTION

PERMIT# 123904 PIN# 4637 06 4717 DATE 10/18/04

OWNER OR CONTRACTOR Rob Buzzi PHONE: Business Home 704-663-6156

ADDRESS 103 Jib Ln. Mooresville, NC. 28117

LOCATION 150 W TL Quiet Cove TR Ridge Top, at intersection on (L)

SUBDIVISION Springlawn BLOCK / SECTION 3 LOT 56 LOT AREA 1.10 SITE CLASS. PS DESIGN FLOW 480 L.T.A.R. ≤ 3

Septic Tank: 1000 Gallons; STB 1012 Date 9/24/04
Pump Tank: 1000 Gallons; PT 17 Date
Pump Make: Model Serial No.
Nitrification Field: No Fields 1 Square Feet 600-900 Linear Feet 300
No Lines 5@60 Trench Width 2-3 Max Trench Bottom Depth 3' Gravel Depth No


[X] New System [ ] Repair System Type: I, II, III, IV, V, VI
System Description: Pressed - 16" PPBPS
Repair System Description: Some
Maintenance Agreement Required: [X] Yes [ ] No

[X] House/Mod. Home No. Bedrooms 4
[ ] Mobile Home No. Bathrooms 4
[ ] Business No. Employees
[ ] Other
[ ] Slab [ ] Crawl Space [X] Basement w/plumbing [ ] Basement wo/plumbing

Water Supply: [X] Individual [ ] Public [ ] Community


Comments/Conditions: 1" = 40'

INITIAL SITE SKETCH

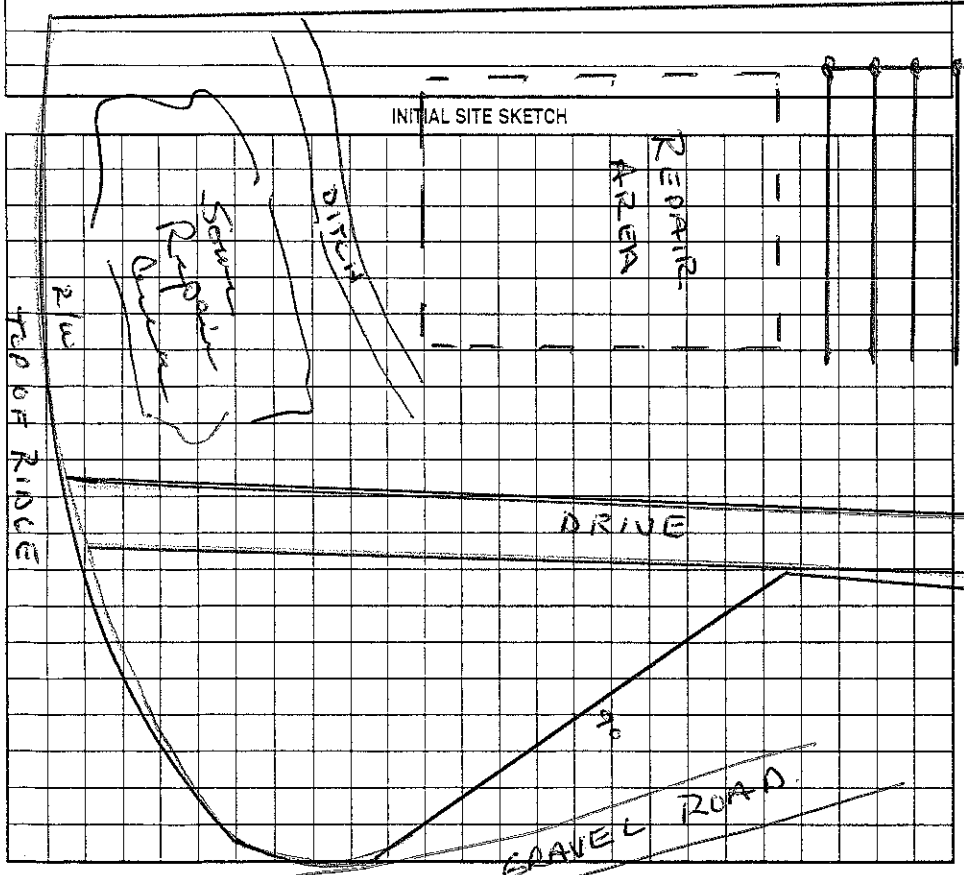

Comments/Conditions: 3 Pc

AS BUILT SKETCH

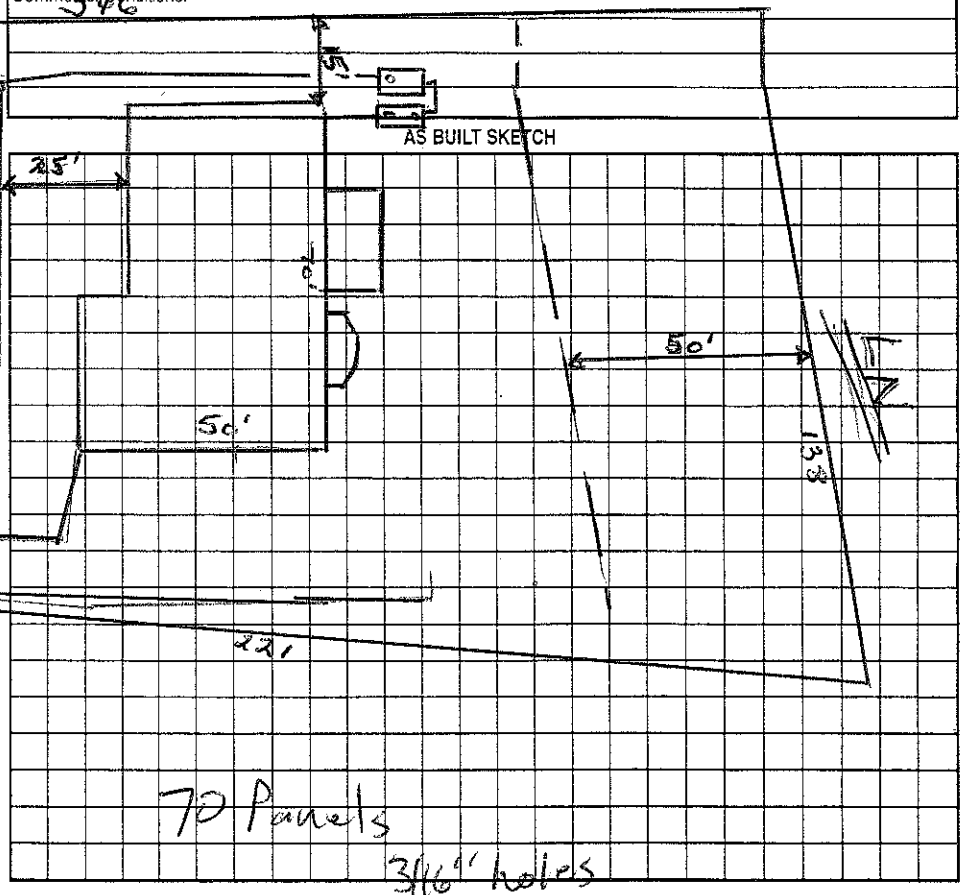

Permit can be suspended or revoked if any false information is supplied toward securing the permit/any unauthorized changes are made to the site/any unauthorized changes are made in the installation of the system. Improvement Permit with plat valid without expiration. Improvement Permit with site plan valid for sixty months. Authorization to Construct is valid for a period equal to that of Improvement Permit -- not to exceed sixty months.

Signed: * BJ Buzzi date 10/21/04 Installed by: C+S Grading

Improvement Permit by: Wesley Sparks RS date 10/18/04 Operation Permit by: RS date 7/13/05

Authorization to Construct by: Wesley Sparks RS date 10/18/04 Existing System Inspection by: date

HEALTH DEPT. COPY: WHITE OWNER COPY (FINAL): YELLOW OWNER COPY (INITIAL): PINK