IREDELL COUNTY HEALTH DEPARTMENT

STATESVILLE 704-878-5305 MOORESVILLE 704-664-5281

IMPROVEMENT PERMIT / AUTHORIZATION TO CONSTRUCT / OPERATION PERMIT / EXISTING SYSTEM INSPECTION

PERMIT# 090835 PIN# 4637067192 DATE 7/31/2000

OWNER OR CONTRACTOR George Warlick PHONE: Business Home 663-5311

ADDRESS 363 Riverwood Rd Mooresville NC 28117

LOCATION Hwy 150 W TL McCrary TR Riverwood on left ~ 1/2 mile - 363 Riverwood

SUBDIVISION C&T BLOCK / SECTION 10 LOT 89 LOT AREA SITE CLASS. DESIGN FLOW L.T.A.R.

Septic Tank: Existing Gallons: STB Date

Pump Tank: Gallons: PT Date

Pump Make: Model Serial No.

Nitrification Field: No Fields Square Feet Linear Feet

No Lines Trench Width Max Trench Bottom Depth Gravel Depth

☐ New System ☐ Repair System Type: I, II, III, IV, V, VI

System Description: Existing Gravity - Conventional

Repair System Description:

Maintenance Agreement Required: ☐ Yes ☒ No

☒ House/Mod. Home No. Bedrooms 2

☐ Mobile Home No. Bathrooms 2

☐ Business No. Employees

☐ Other

☐ Slab ☐ Crawl Space ☐ Basement w/plumbing ☐ Basement wo/plumbing

Water Supply: ☒ Individual ☐ Public ☐ Community


Comments:/Conditions: Existing Septic System appears to be functioning Okay at time of inspection; No problems noticed.

*NOT TO SCALE

Comments:/Conditions: Place new home at least 5' from Existing Septic System

Replacing Single Wide (SW) with new SW

INITIAL SITE SKETCH

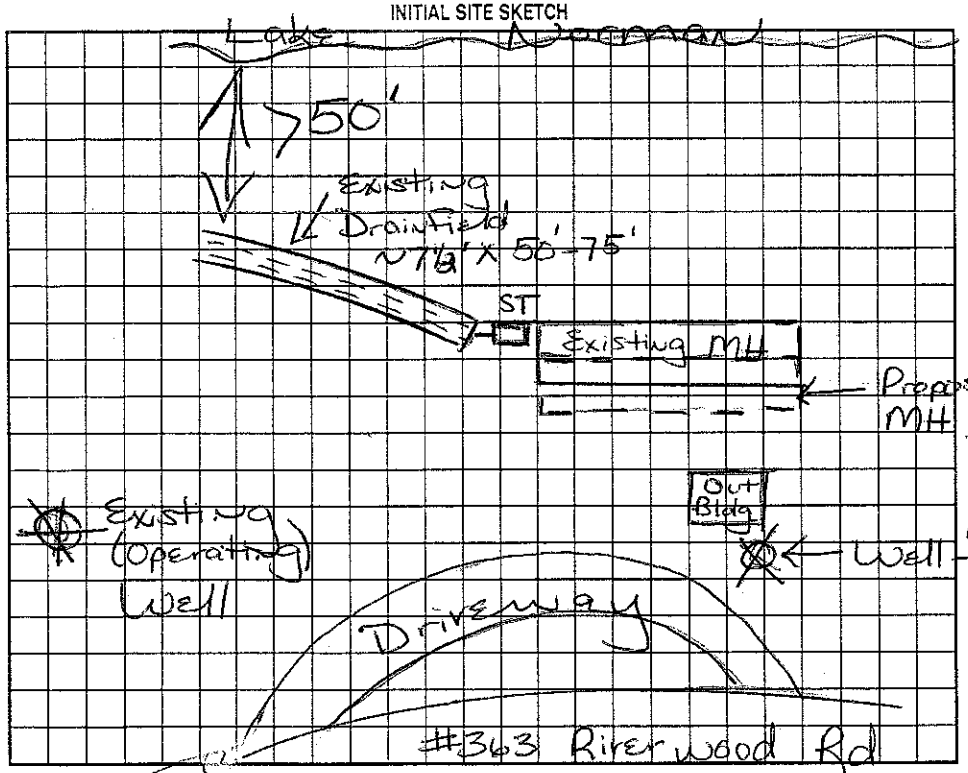

AS BUILT SKETCH

Permit can be suspended or revoked if any false information is supplied toward securing the permit/any unauthorized changes are made to the site/any unauthorized changes are made in the installation of the system. Improvement Permit with plat valid without expiration. Improvement Permit with site plan valid for sixty months. Authorization to Construct is valid for a period equal to that of Improvement Permit – not to exceed sixty months.

Signed: date

Improvement Permit by: Maria H. Dobson RS date 7/31/2000

Authorization to Construct by: date

Installed by:

Operation Permit by: date

Existing System Inspection by: Maria H. Dobson RS date 7/31/2000

HEALTH DEPT. COPY: WHITE OWNER COPY (FINAL): YELLOW OWNER COPY (INITIAL): PINK