IREDELL COUNTY HEALTH DEPARTMENT

Auth injection to Construct

463707 0060

STATESVILLE 704-878-5305 MOORESVILLE 704-664-5281

IMPROVEMENT PERMIT / CERTIFICATE OF COMPLETION / OPERATION PERMIT / EXISTING SYSTEM INSPECTION

PROPERTY DESCRIPTION NO. 16878 DATE 3/12/96 TAX MAP NO. 2N A 30 Watershed: ☐ Yes ☒ No

OWNER OR CONTRACTOR Mark Harper PHONE: Business 478-3766 Home

ADDRESS 1651 Lake Front Dr. Catawba, NC. 28609

LOCATION Ridge Top Rd; 150' TR into Spring Acres, TR Ridge Top Rd. to 7th lot on (R)

SUBDIVISION Spring Acres BLOCK / SECTION III LOT 61 LOT AREA .52AC SITE CLASS P-5 DESIGN FLOW 360 L.T.A.R. .3

Septic Tank: 1080 Gallons; STB 786 Date 6/12/96

Pump Tank: Gallons; PT Date

Pump Make: Model Serial No.

Nitrification Field: No Fields 1 Square Feet 1200 Linear Feet *300

No Lines 4 Trench Width 36" Max Trench Bottom Depth 36"

☒ New System ☐ Repair System Type: I. II. (III) IV. V. VI

System Description: * Plastic Chambers

Repair System Description: Same

Maintenance Agreement Required: ☐ Yes ☒ No

Gravel Depth 6" STONE ☐ Slab ☒ Crawl Space ☐ Basement w/plumbing ☐ Basement wo/plumbing

☒ House/Mod. Home No. Bedrooms 3

☐ Mobile Home No. Bathrooms 2

☐ Business No. Employees

☐ Other


Water Supply: ☒ Individual ☐ Community ☐ Public

Comments: Sand backfill to top of louvers of each chamber section.


Pump may be necessary if foundation is not raised sufficiently.

Comments: WELL NOT LOCATED AT TIME OF INSPECTION.

INITIAL SITE SKETCH

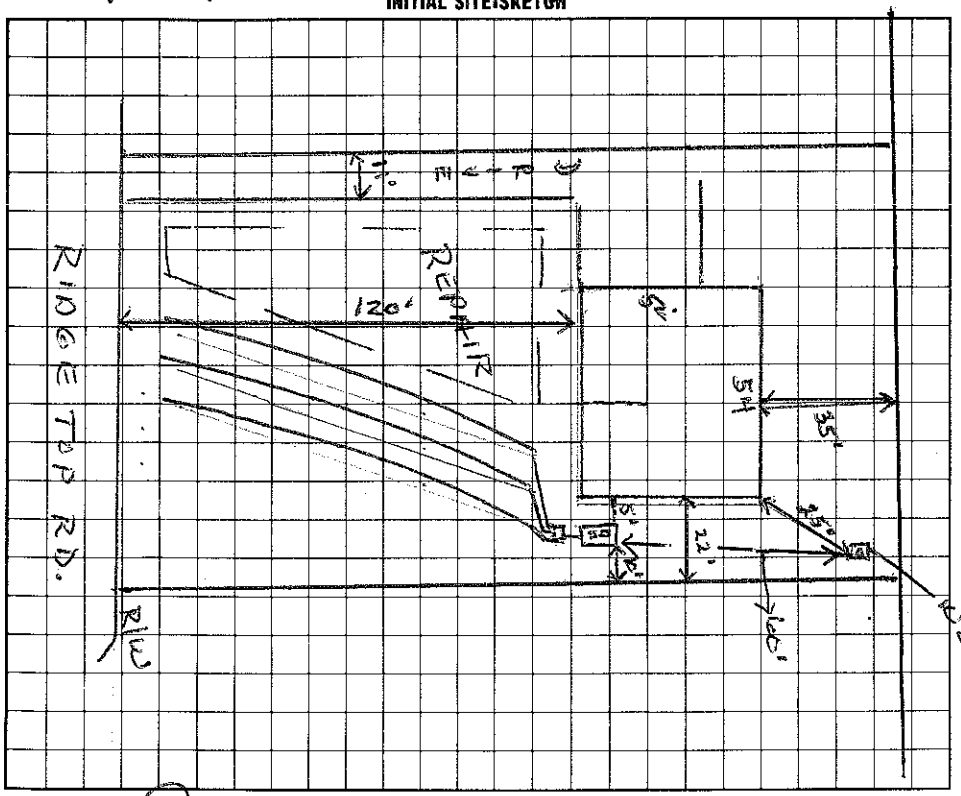

AS BUILT SKETCH

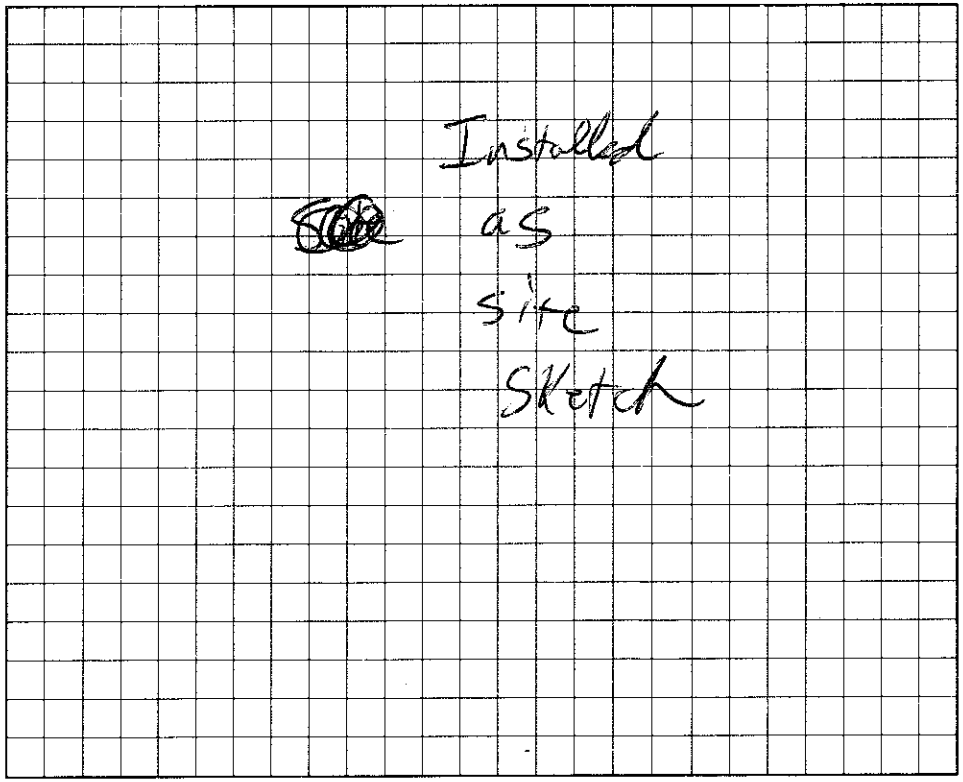

I understand that this permit can be suspended or revoked if any false information is supplied toward securing the permit/any unauthorized changes are made to the site/any unauthorized changes are made in the installation of the system.

Signed: James M. Harper

Improvement Permit by: Wesley Sparks RS. date 3/13/96

Auth Existing System Inspection by: Wesley Sparks RS. date 3/13/96

Installed by: KENNEDY GRADING

Certificate of Completion by: date

Operation Permit by: Charles Farmer BHSI date 10/4/96

HEALTH DEPT. COPY: WHITE INSPECTION COPY (FINAL): GREEN OWNER COPY (FINAL): YELLOW INSPECTION COPY (INITIAL): PINK OWNER COPY (INITIAL): GOLD