IREDELL COUNTY HEALTH DEPARTMENT

Authorization to Construct

STATESVILLE 704-878-5305 MOORESVILLE 704-664-5281

IMPROVEMENT PERMIT / ~~CERTIFICATE OF COMPLETION~~ / OPERATION PERMIT / EXISTING SYSTEM INSPECTION

PROPERTY DESCRIPTION NO. 16877 DATE 3/13/96 TAX MAP NO. 2PA 2e 4637 07 0110 Watershed: ☐ Yes ☒ No

OWNER OR CONTRACTOR Mark Harper PHONE: Business 478-3766 Home

ADDRESS 1651 Lake Front Dr. Cornelius NC 28609

LOCATION Ridge Top Rd; 150W into Spring Acres TR Ridge Top on 6th house on (R)

SUBDIVISION Spring Acres BLOCK / SECTION 3 LOT 62 LOT AREA .52 ac SITE CLASS P3 DESIGN FLOW 360 L.T.A.R. .3

Septic Tank: 1000 Gallons; STB 786 Date 6/5/96

Pump Tank: 1000 Gallons; PT Date

Pump Make: Model Serial No.

Nitrification Field: No Fields 1 Square Feet 1200 Linear Feet ~~X~~ 300

No Lines 4 Trench Width 36" Max Trench Bottom Depth 36" Gravel Depth 6" SPEC.

☒ New System ☐ Repair System Type: I. II. (III) IV. V. VI

System Description: ~~X~~ Pressure - Plastic Chamber

Repair System Description: ~~Same~~ PANEL

Maintenance Agreement Required: ☐ Yes ☒ No

☒ House/Mod. Home No. Bedrooms 3

☐ Mobile Home No. Bathrooms 2

☐ Business No. Employees

☐ Other


☐ Slab ☒ Crawl Space ☐ Basement w/plumbing ☐ Basement wo/plumbing

Water Supply: ☒ Individual ☐ Community ☐ Public

Comments: 8/1/96 - changed by WS - Pump elevated after inspection

Comments:

INITIAL SITE SKETCH

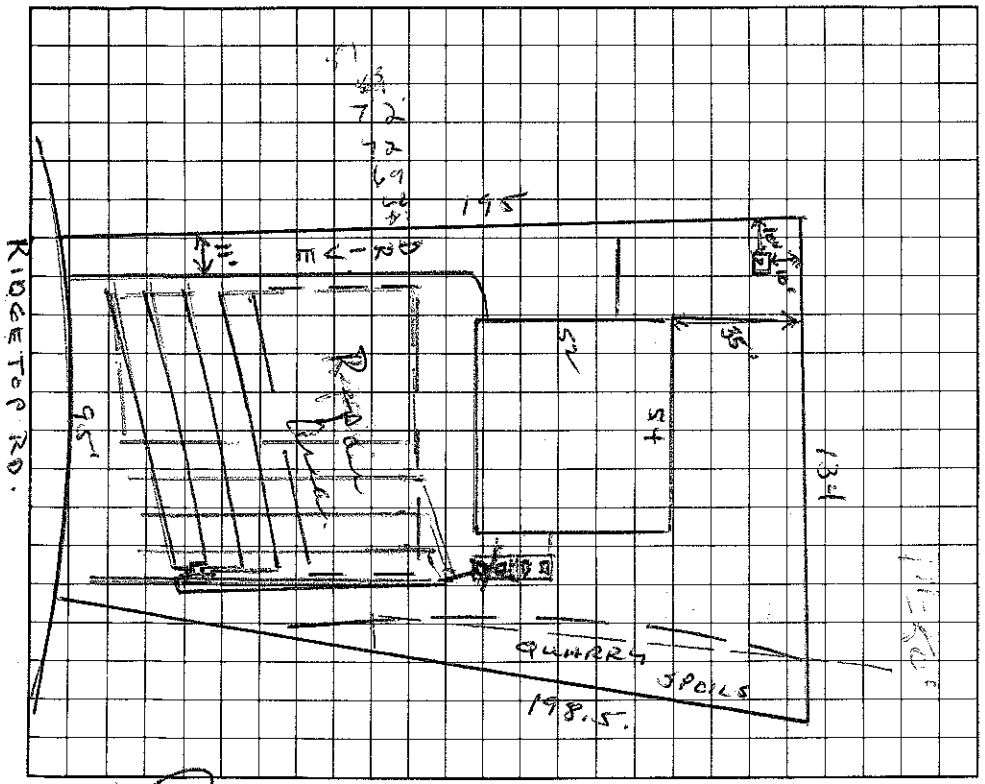

AS BUILT SKETCH

I understand that this permit can be suspended or revoked if any false information is supplied toward securing the permit/any unauthorized changes are made to the site/any unauthorized changes are made in the installation of the system.

Signed: ~~X~~ James M Harper

Improvement Permit by: Wesley Sparks RS. date 3/13/96

Existing System Inspection by: Construct Wesley Sparks RS. date 3/13/96

Installed by: KENNEDY GRADING

Certificate of Completion by: date

Operation Permit by: C. Bryan Freeman EHSE date 10/7/96

HEALTH DEPT. COPY: WHITE INSPECTION COPY (FINAL): GREEN OWNER COPY (FINAL): YELLOW INSPECTION COPY (INITIAL): PINK OWNER COPY (INITIAL): GOLD