IREDELL COUNTY HEALTH DEPARTMENT

STATESVILLE 704-878-5305 MOORESVILLE 704-664-5281

IMPROVEMENT PERMIT / AUTHORIZATION TO CONSTRUCT / OPERATION PERMIT / EXISTING SYSTEM INSPECTION

PERMIT# 16886 PIN# 2N A 2e Pt of F. 4637-07-2192 DATE 11/16/99

OWNER OR CONTRACTOR Van Thomas PHONE: Business Home 828-478-9442

ADDRESS Ridge Top. Rd. Mooresville, NC. 28115

LOCATION 150 W TL Quiet Cove Rd TR Ridge Top Rd. to 4th lot on (L)

SUBDIVISION Spring Acres BLOCK / SECTION 3 LOT 53 LOT AREA .8 Ac SITE CLASS. PS DESIGN FLOW 360 L.T.A.R. .3

Septic Tank: 1000 Gallons; STB 1612 Date 9/30/99
Pump Tank: 1000 Gallons; PT 17 Date 6/1/99
Pump Make: MYERS Model ME-46 Serial No.
Nitrification Field: No Fields 1 Square Feet 900* Linear Feet 300*
No Lines 3 Trench Width 36" Max Trench Bottom Depth 36" Gravel Depth 3 AND.

☒ New System ☐ Repair System Type: I, II, (III), IV, V, VI
System Description: Pres Man to HDS on Ch. Plas.
Repair System Description: Pressure 16" Panel Block
Maintenance Agreement Required: ☐ Yes ☒ No

☒ House/Mod. Home No. Bedrooms 3
☐ Mobile Home No. Bathrooms 3
☐ Business No. Employees
☐ Other


☐ Slab ☐ Crawl Space ☒ Basement w/plumbing ☐ Basement wo/plumbing

Water Supply: ☒ Individual ☐ Public ☐ Community


Comments:/Conditions: * May use HDS on Chamber Plastic from Pressure Manifold

Comments:/Conditions:

INITIAL SITE SKETCH (1"=50')

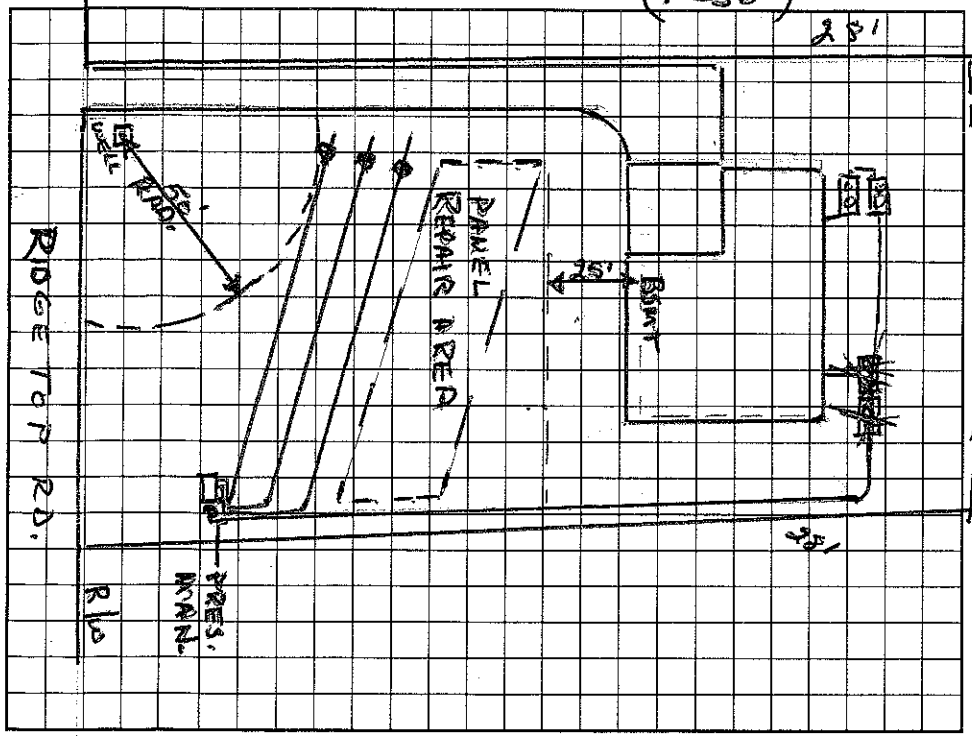

AS BUILT SKETCH

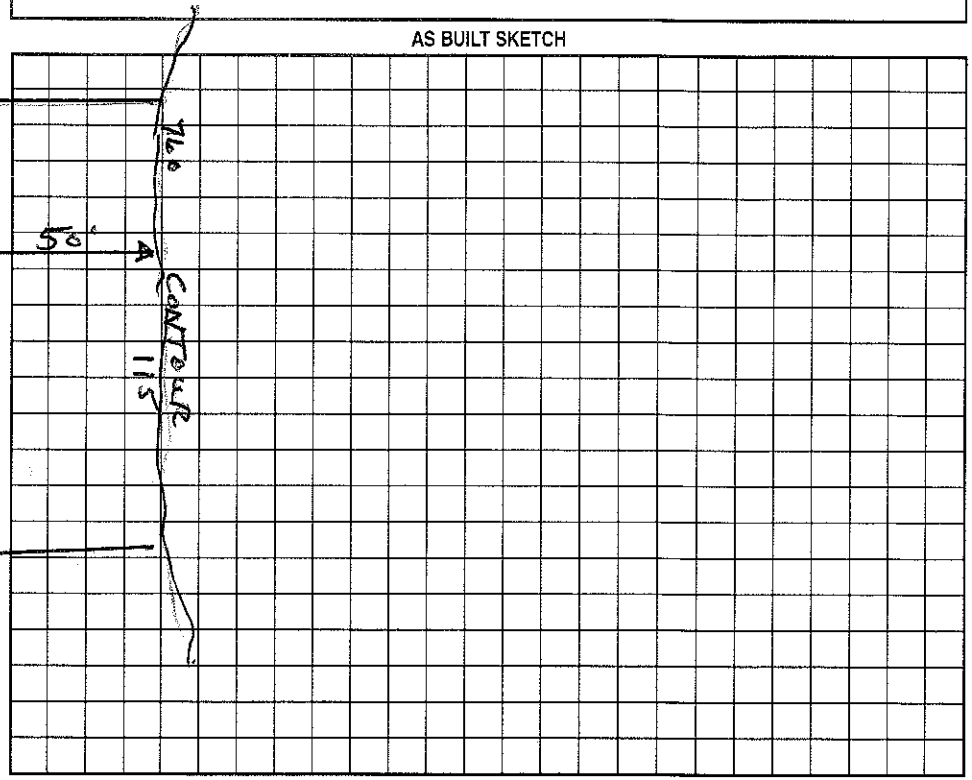

Permit can be suspended or revoked if any false information is supplied toward securing the permit/any unauthorized changes are made to the site/any unauthorized changes are made in the installation of the system. Improvement Permit with plat valid without expiration. Improvement Permit with site plan valid for sixty months. Authorization to Construct is valid for a period equal to that of Improvement Permit – not to exceed sixty months.

Signed: * Troy G Smith date

Installed by: Richard Abernathy

Improvement Permit by: Wesley Sparks R.S. date 11/16/99

Operation Permit by: Wesley Sparks R.S. date 12/9/99

Authorization to Construct by: Wesley Sparks R.S. date 11/16/99

Existing System Inspection by: date

HEALTH DEPT. COPY: WHITE OWNER COPY (FINAL): YELLOW OWNER COPY (INITIAL): PINK