IREDELL COUNTY HEALTH DEPARTMENT

STATESVILLE 704-878-5305 130.00 Paid MOORESVILLE 704-664-5281 11:30

IMPROVEMENT PERMIT / AUTHORIZATION TO CONSTRUCT / OPERATION PERMIT / EXISTING SYSTEM INSPECTION

PERMIT# 126258 PIN# 4637072550 DATE 2-24-05

OWNER OR CONTRACTOR John Czerwinski PHONE: Business 704 807-4699 Home

ADDRESS 637 Williamson Rd #107 Mooresville NC 28117

LOCATION Hwy 150 West TL Quiet Cove TR Ridgetop on left

SUBDIVISION Spring Acres BLOCK / SECTION III LOT 50 LOT AREA .6 Acre± SITE CLASS. PS DESIGN FLOW 360 gpd L.T.A.R. .3

Septic Tank: 1000 Gallons; STB 1012 Date 8-23-05
Pump Tank: 1000 Gallons; PT 1012 Date 2-28-06
Pump Make: Goulds Model WE05 HH Serial No.
Nitrification Field: No Fields 1 Square Feet 400 Linear Feet 200'
No Lines 4@50 Trench Width 24"-36" Max Trench Bottom Depth 36" Gravel Depth N/A

X New System ☐ Repair System Type: I, II, III, IV, V, VI
System Description: Pump-PM-Panel Block
Repair System Description: Same
Maintenance Agreement Required: ☐ Yes ☐ No


X House/Mod. Home No. Bedrooms 3
☐ Mobile Home No. Bathrooms 3
☐ Business No. Employees
☐ Other
☐ Slab ☐ Crawl Space X Basement w/plumbing ☐ Basement wo/plumbing

Water Supply: X Individual ☐ Public ☐ Community

Comments/Conditions: Keep Septic System at least 10' from PL, 50' from lake & 50' from well Keep Drainfield 25' to basement wall & tanks 15' from basement wall.

Comments/Conditions: XX Note: IF grading for drive results in vertical cut > 2ft. than top edge of embankment must be 15ft. from Drainfield & Repair.

Scale 1"=50 INITIAL SITE SKETCH

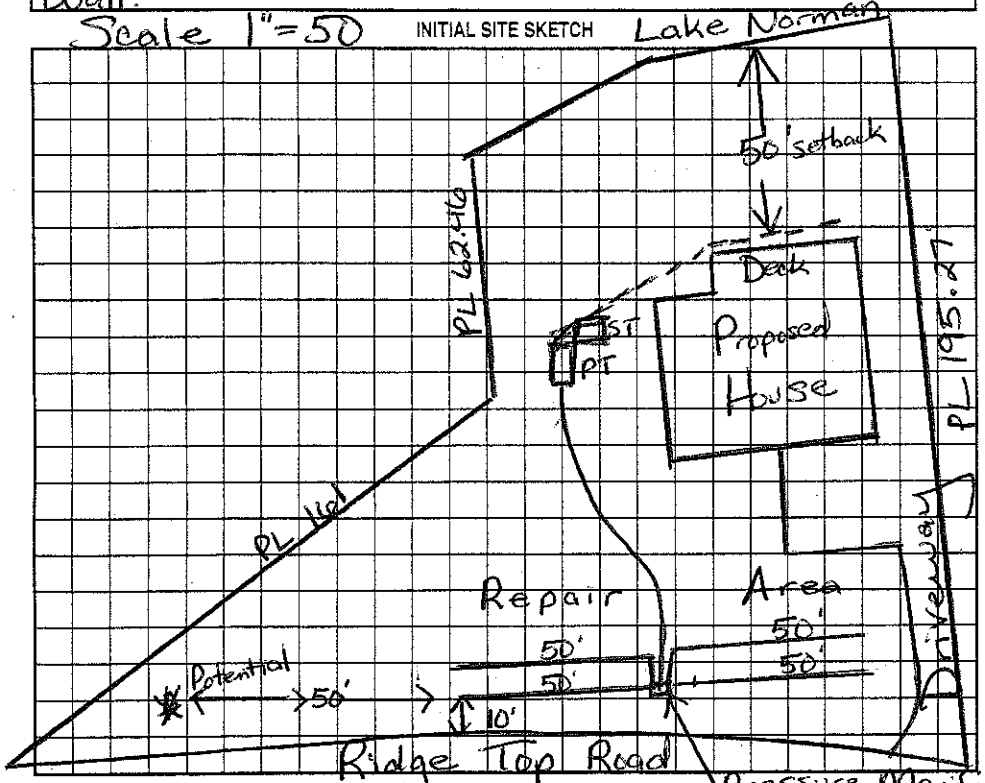

AS BUILT SKETCH

Installed Drainfield as Shown

Permit can be suspended or revoked if any false information is supplied toward securing the permit/any unauthorized changes are made to the site/any unauthorized changes are made in the installation of the system. Improvement Permit with plat valid without expiration. Improvement Permit with site plan valid for sixty months. Authorization to Construct is valid for a period equal to that of Improvement Permit – not to exceed sixty months.

Signed: John Czerwinski date 3/2/05 Installed by: C & S Grading

Improvement Permit by: Maria H Dotson RS date 2/24/05 Operation Permit by: RS date 7/14/06

Authorization to Construct by: Maria H Dotson RS date 2/24/05 Existing System Inspection by: date

HEALTH DEPT. COPY: WHITE OWNER COPY (FINAL): YELLOW OWNER COPY (INITIAL): PINK