Anthony Franks Construct 4637075373 10/97

IREDELL COUNTY HEALTH DEPARTMENT

STATESVILLE 704-878-5305 MOORESVILLE 704-664-5281

IMPROVEMENT PERMIT / ~~CERTIFICATE OF COMPLETION~~ / OPERATION PERMIT / EXISTING SYSTEM INSPECTION

PROPERTY DESCRIPTION NO. 65577 DATE 4/1/97 TAX MAP NO. ~~4637076304~~ Watershed: ☒ Yes ☐ No

OWNER OR CONTRACTOR Ken Clonts. PHONE: Business ________ Home 662-8703 WS IV-CA

ADDRESS 102 B Superior Dr. Mooresville, NC. 28115

LOCATION Quiet Cove Ln. on (R) just before cul de sac

SUBDIVISION Spring Acres BLOCK / SECTION ________ LOT 4 LOT AREA .51 AC SITE CLASS. PS DESIGN FLOW 360 L.T.A.R. .3

Septic Tank: 1000 Gallons; STB 794 Date 9-97

Pump Tank: 1000 Gallons; PT 27 Date 7/28/97

Pump Make: Zoeller Model 141 B Serial No. ——

Nitrification Field: No Fields 1 Square Feet 420* Linear Feet 210

No Lines 3 Trench Width 24" Max Trench Bottom Depth 30" Gravel Depth SAND

☒ New System ☐ Repair System Type: I, II, (III), IV, V, VI

System Description: Pres Man – 16" PPBS

Repair System Description: Same

Maintenance Agreement Required: ☐ Yes ☒ No

☒ House/Mod. Home ☐ Mobile Home ☐ Business ☐ Other ________

No. Bedrooms 3 No. Bathrooms 3 No. Employees ____


☐ Slab ☒ Crawl Space ☐ Basement w/plumbing ☐ Basement wo/plumbing

Water Supply: ☒ Individual ☐ Community ☐ Public


Comments: * 50% reduction for use of 16" PPBS

Comments: 5.75" Drawdown

INITIAL SITE SKETCH

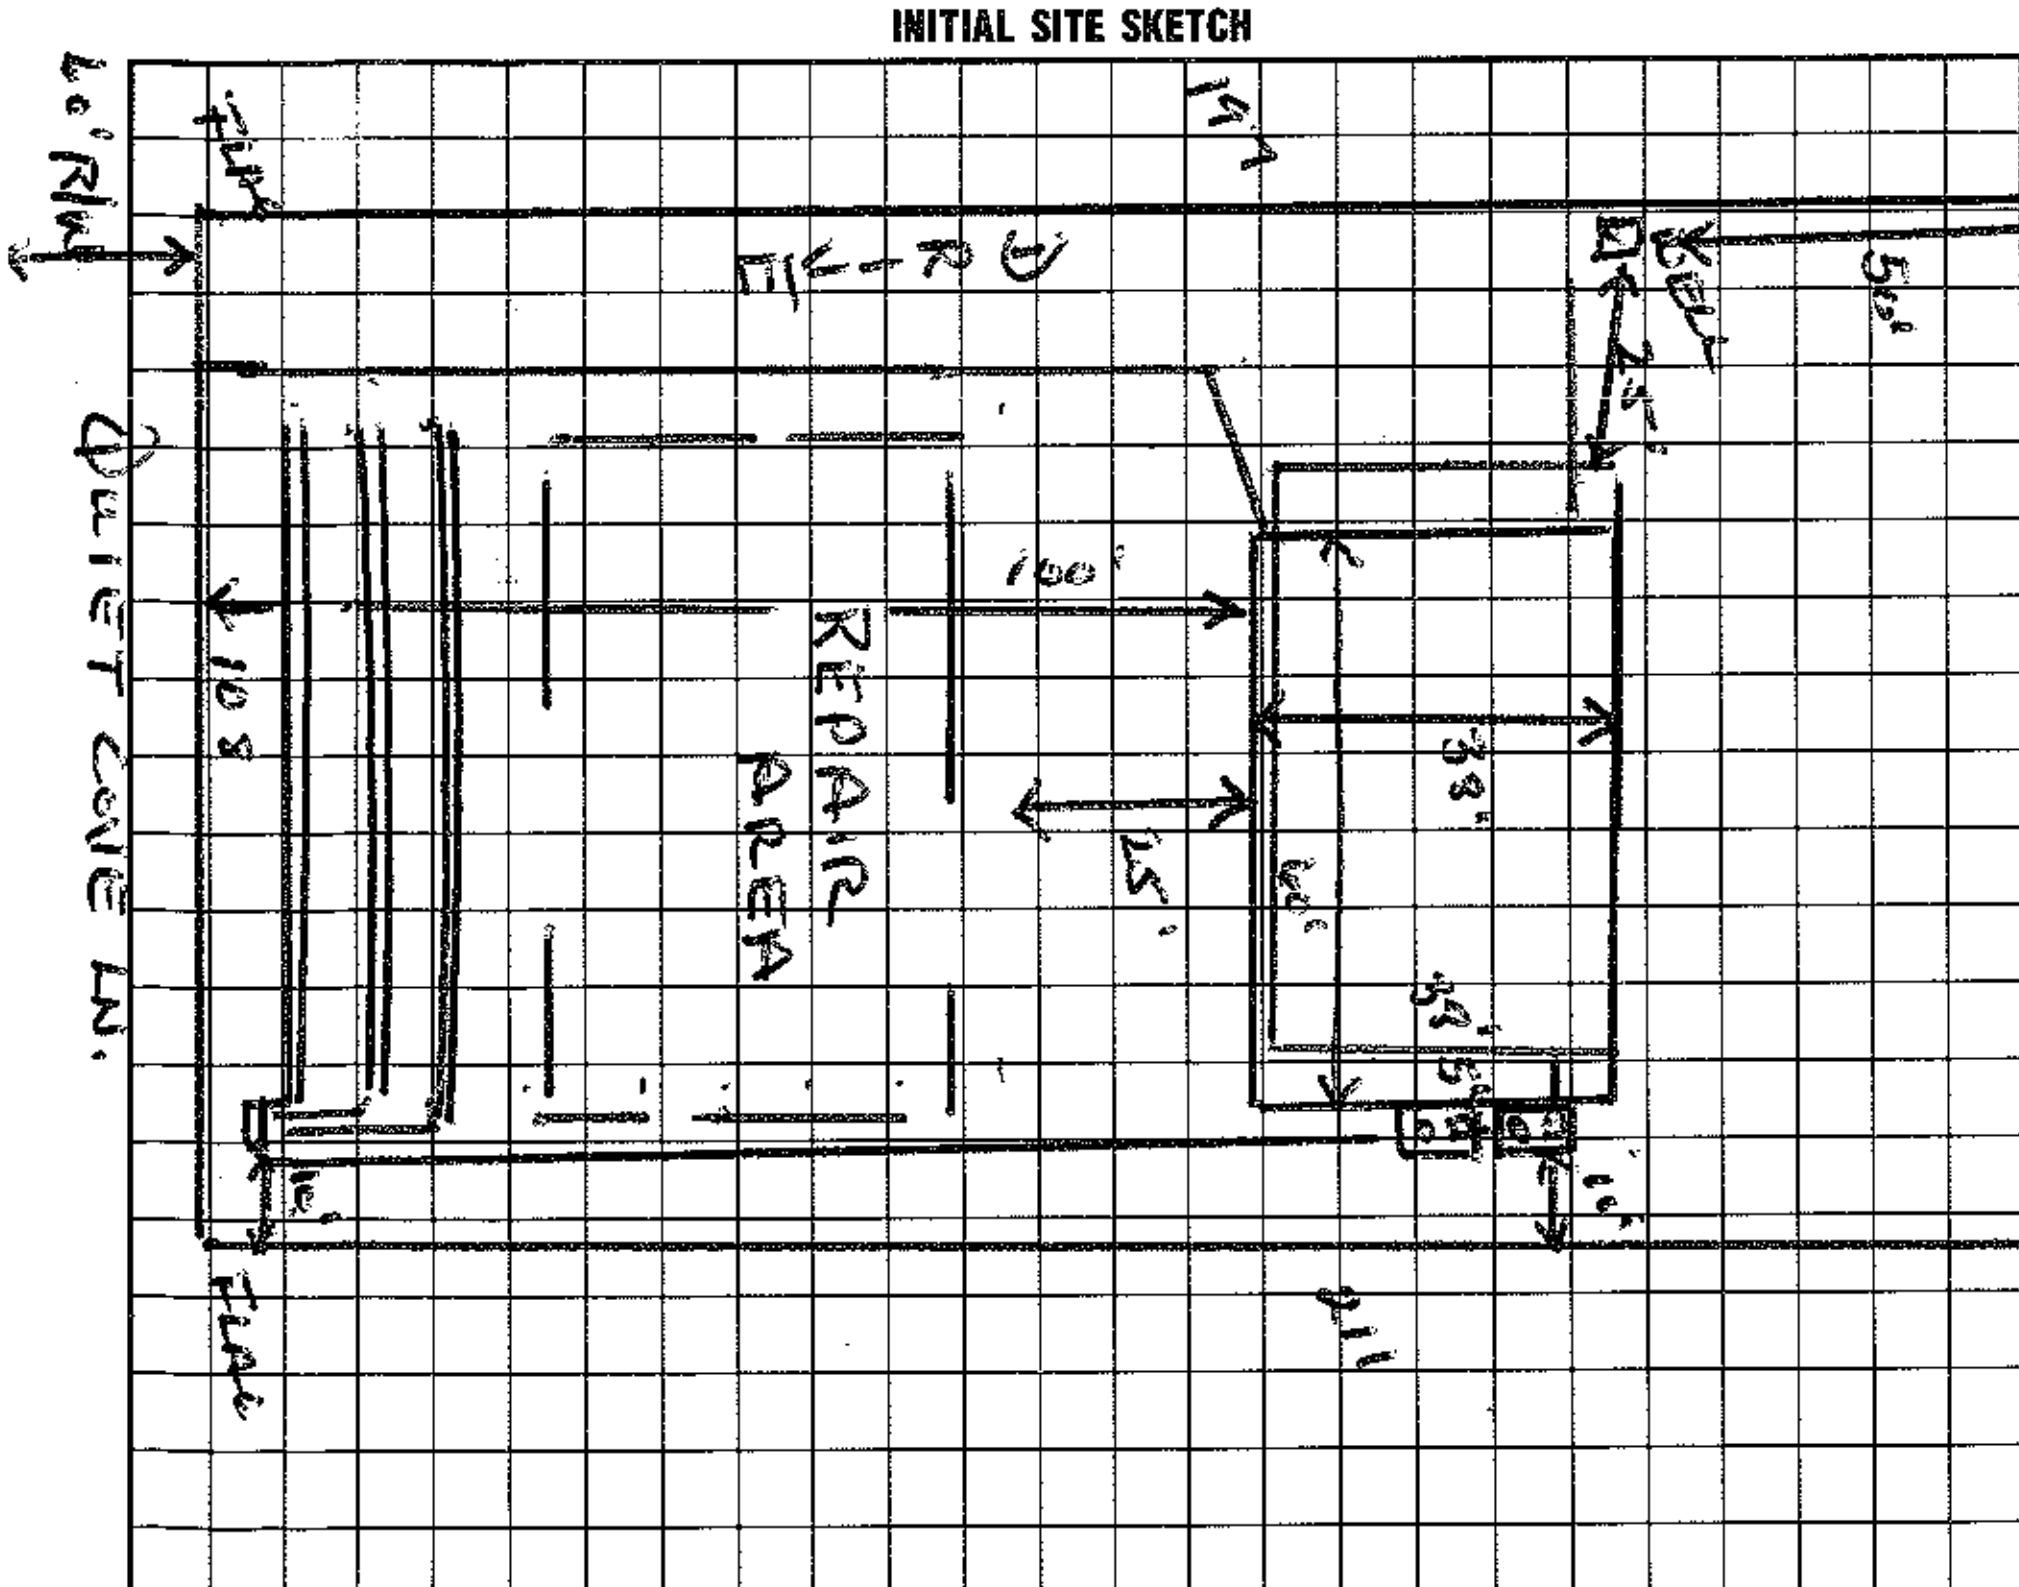

AS BUILT SKETCH

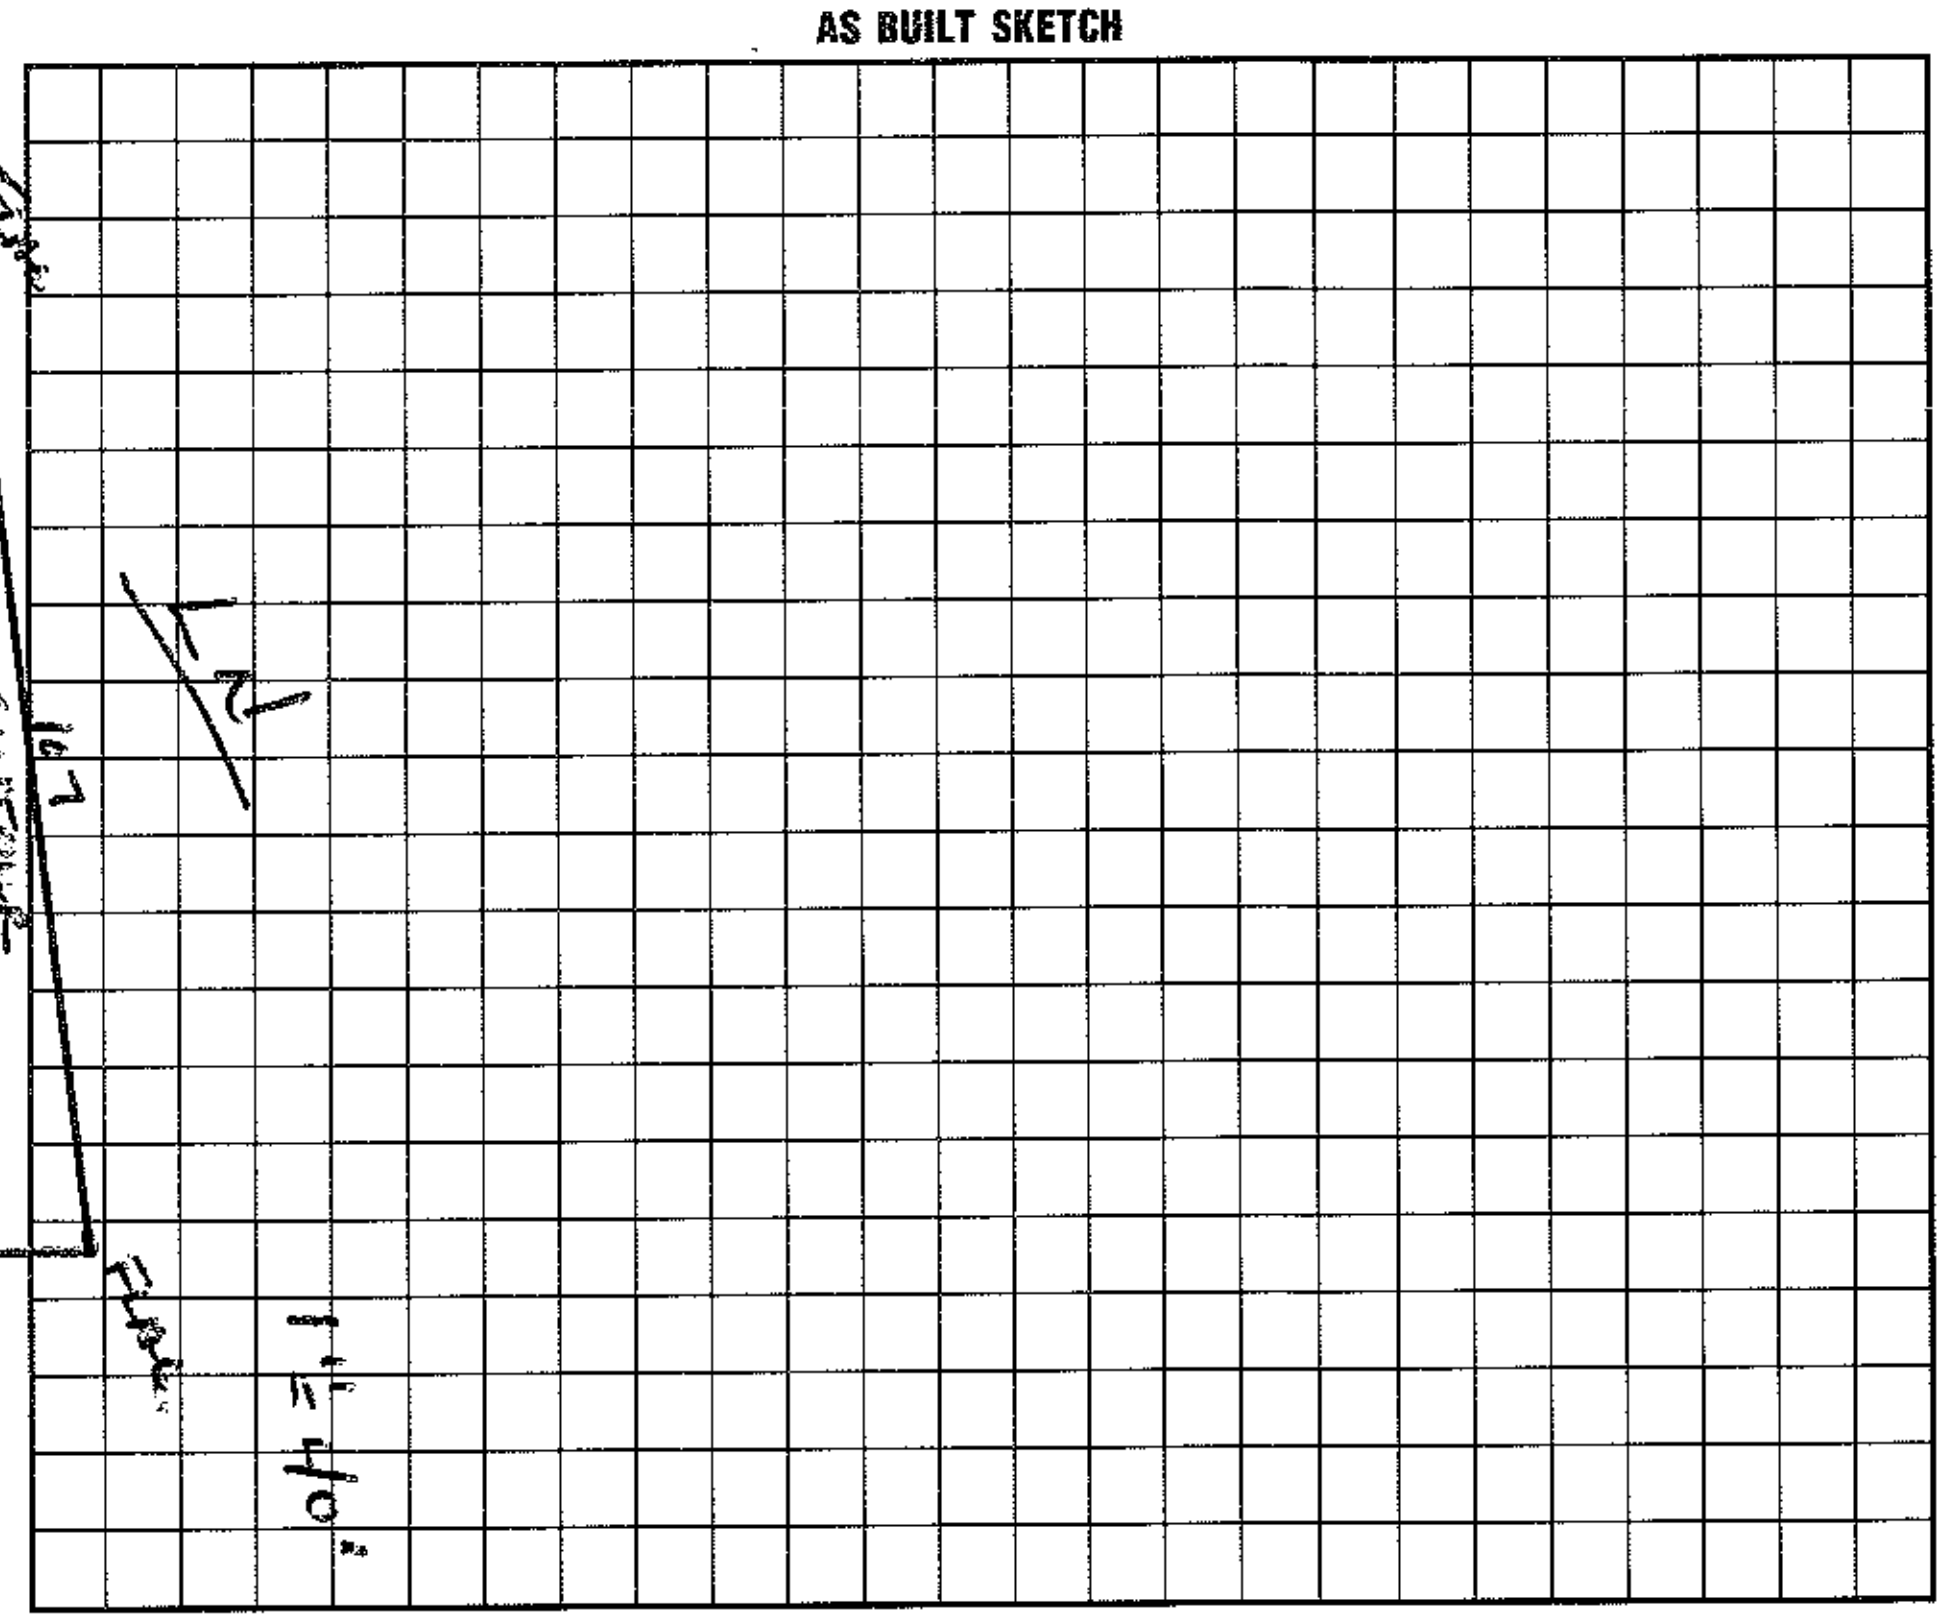

I understand that this permit can be suspended or revoked if any false information is supplied toward securing the permit/any unauthorized changes are made to the site/any unauthorized changes are made in the installation of the system. Improvement Permit is valid for 60 months from date of issuance.

Signed: * [signature]

Improvement Permit by: Wesley Speaks R.S. date 4/1/97

Existing System Inspection by: Wesley Speaks R.S. date 4/1/97

Auth. C.

Installed by: Buddy Cheney

Certificate of Completion by: ________ date ____

Operation Permit by: C. [signature] date 11/3/97

HEALTH DEPT. COPY: WHITE INSPECTION COPY (FINAL): GREEN OWNER COPY (FINAL): YELLOW INSPECTION COPY (INITIAL): PINK OWNER COPY (INITIAL): GOLD