IREDELL COUNTY HEALTH DEPARTMENT

STATESVILLE 704-878-5305 MOORESVILLE 704-664-5281

IMPROVEMENT PERMIT / CERTIFICATE OF COMPLETION / OPERATION PERMIT / EXISTING SYSTEM INSPECTION

PROPERTY DESCRIPTION NO. 17714 DATE April 8 '94 TAX MAP NO. 2L7A3 4637.67.5443

OWNER OR CONTRACTOR ~~Jean Woodie~~ Steve & Jennifer FORD PHONE: Business Home 846-8995

ADDRESS ~~17201 Jacobs Grove Dr.~~ Charlotte NC 28210 Nantique Blvd. #303 Cornelius 28031

LOCATION 150W TL Quiet Cove Rd. ~¼ mile on right Watershed: ☑ Yes ☐ No L.N.

SUBDIVISION Spruce Acres BLOCK / SECTION LOT 3 LOT AREA ~~20,000 ft²~~ ~~w/off site sewer easement~~ Easement PS pr. 1956 SITE CLASS: DESIGN FLOW 360gpd L.T.A.R. -3 (easement)

Septic Tank: 1000 Gallons; STB 794 Date 11/13/93

Pump Tank: 1600 Gallons; PT 27 Date 11/12/94

Pump Make: ZOELLER Model N140-5 Serial No. 140-0002

Nitrification Field: No. Fields 1 Square Feet Linear Feet 200

No Lines ~~5~~ (4) Trench Width 24" Max Trench Bottom Depth 36"

☐ New System ☐ Repair System Type: I, II, III, IV, V, VI

System Description: LP/PPBPS

Repair System Description: SAME SURFACE DISPOSAL

Maintenance Agreement Required: ☑ Yes ☐ No

Gravel Depth N/A

☑ House/Mod. Home No. Bedrooms 3

☐ Mobile Home No. Bathrooms 4

☐ Business No. Employees

☐ Other


☐ Slab ☐ Crawl Space ☑ Basement w/plumbing ☐ Basement wo/plumbing

Water Supply: ☑ Individual ☐ Community ☐ Public

Comments: On site consultation required prior to installing septic system. Elevation head to be determined at time pump tank is set.

Comments: 3.5' Downspout. Press. Manifold Pressure Manifold and phone 363-5859

INITIAL SITE SKETCH

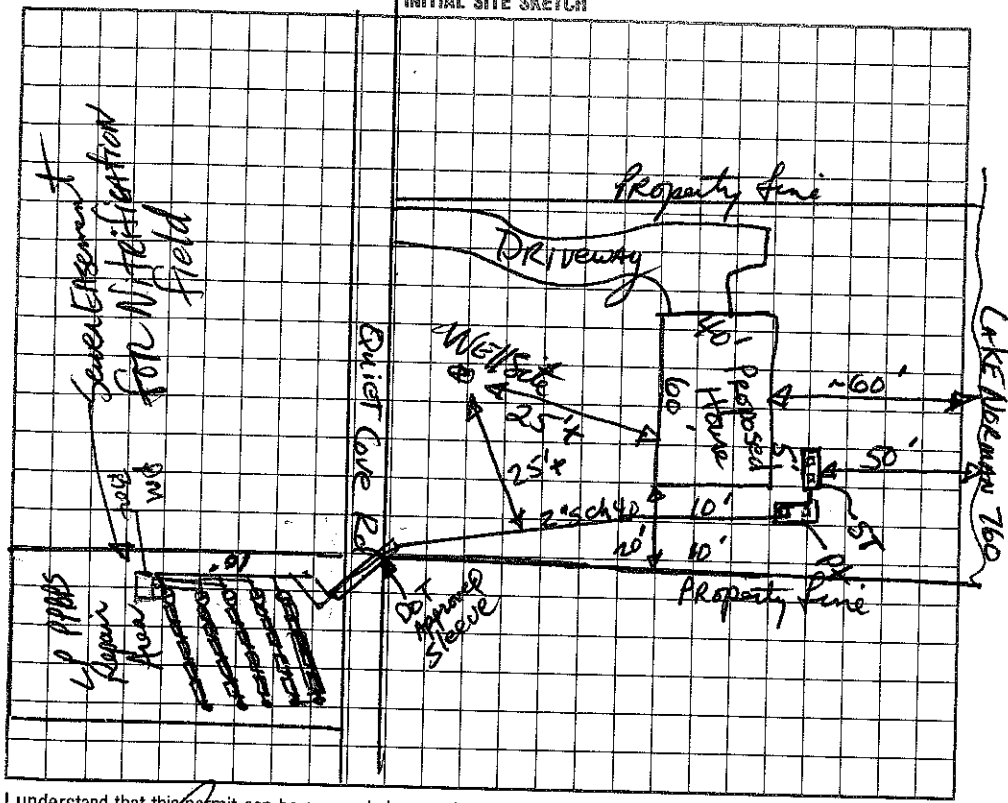

AS BUILT SKETCH

I understand that this permit can be suspended or revoked if any false information is supplied toward securing the permit/any unauthorized changes are made to the site/any unauthorized changes are made in the installation of the system. Improvement Permit is valid for 60 months from date of issuance.

Signed:

Improvement Permit by: date 4/8/94

~~Existing System Inspection by:~~ Authorized Agent date 5/26/98

Installed by: Buddy Chaney

Certificate of Completion by: date

Operation Permit by: Wesley Sparks R.S. date 3/11/99

HEALTH DEPT. COPY: WHITE INSPECTION COPY (FINAL): GREEN OWNER COPY (FINAL): YELLOW INSPECTION COPY (INITIAL): PINK OWNER COPY (INITIAL): GOLD