IREDELL COUNTY HEALTH DEPARTMENT

Authorization to Construct

STATESVILLE 704-878-5305 MOORESVILLE 704-664-5281

IMPROVEMENT PERMIT / ~~CERTIFICATE OF COMPLETION~~ / OPERATION PERMIT / EXISTING SYSTEM INSPECTION

PROPERTY DESCRIPTION NO. 24 121 DATE 6/12/96 TAX MAP NO. 2L 7 5 Watershed: [X] Yes [ ] No

OWNER OR CONTRACTOR Morris Stoneworks PHONE: Business 663-7803 Home

ADDRESS Hwy 150 W Mooresville, NC 28115

LOCATION 150 W on (L) before Quiet Cove Rd.

SUBDIVISION Spring Acres BLOCK / SECTION LOT 5 LOT AREA 21.28 Ac SITE CLASS PS DESIGN FLOW 300 L.T.A.R. .3

Septic Tank: 1000 Gallons; STB 825 Date 10/11/96

Pump Tank: Gallons; PT Date

Pump Make: Model Serial No.

Nitrification Field: No Fields 1 Square Feet 1000 Linear Feet 333

No Lines 4 Trench Width 36" Max Trench Bottom Depth 30" Gravel Depth 12"

[X] New System [ ] Repair System Type: I (II) III. IV. V. VI

System Description: CONV - DIST BOX

Repair System Description: Pressure Dosed

Maintenance Agreement Required: [ ] Yes [X] No

[ ] House/Mod. Home No. Bedrooms

[ ] Mobile Home No. Bathrooms

[X] Business No. Employees 12

[ ] Other


Water Supply: [X] Individual [ ] Community [ ] Public

[X] Slab [ ] Crawl Space [ ] Basement w/plumbing [ ] Basement wo/plumbing


Comments: 6-5 6-7 6-9 6-3 6-5 6-9

Comments:

INITIAL SITE SKETCH

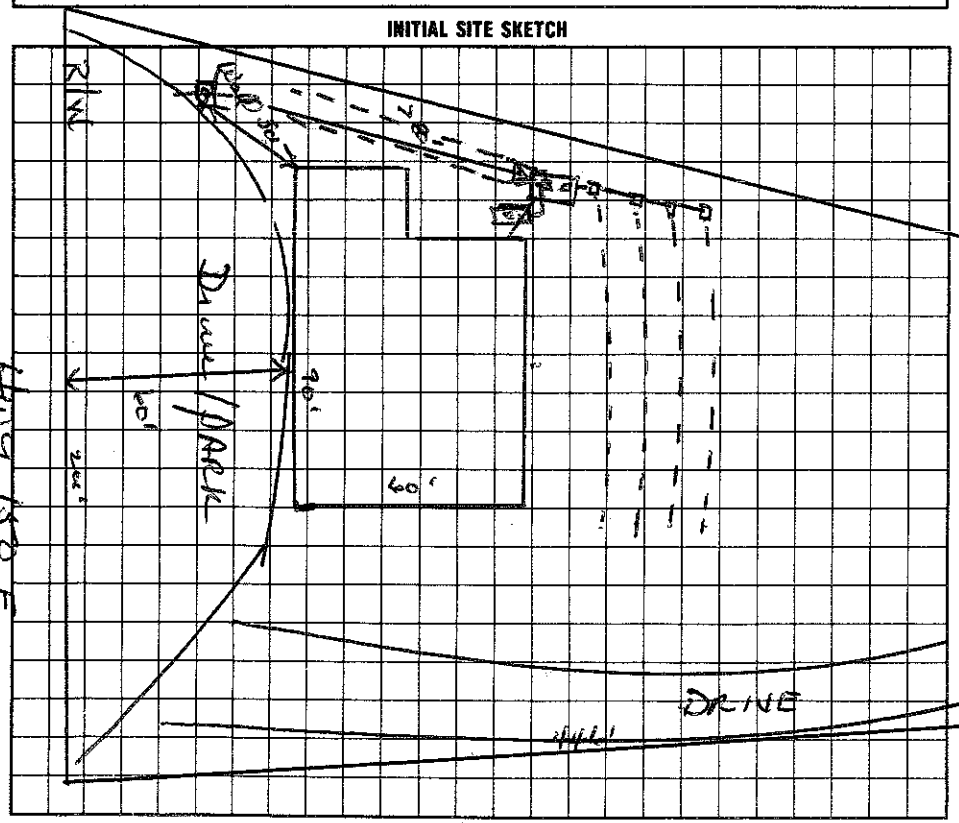

AS BUILT SKETCH

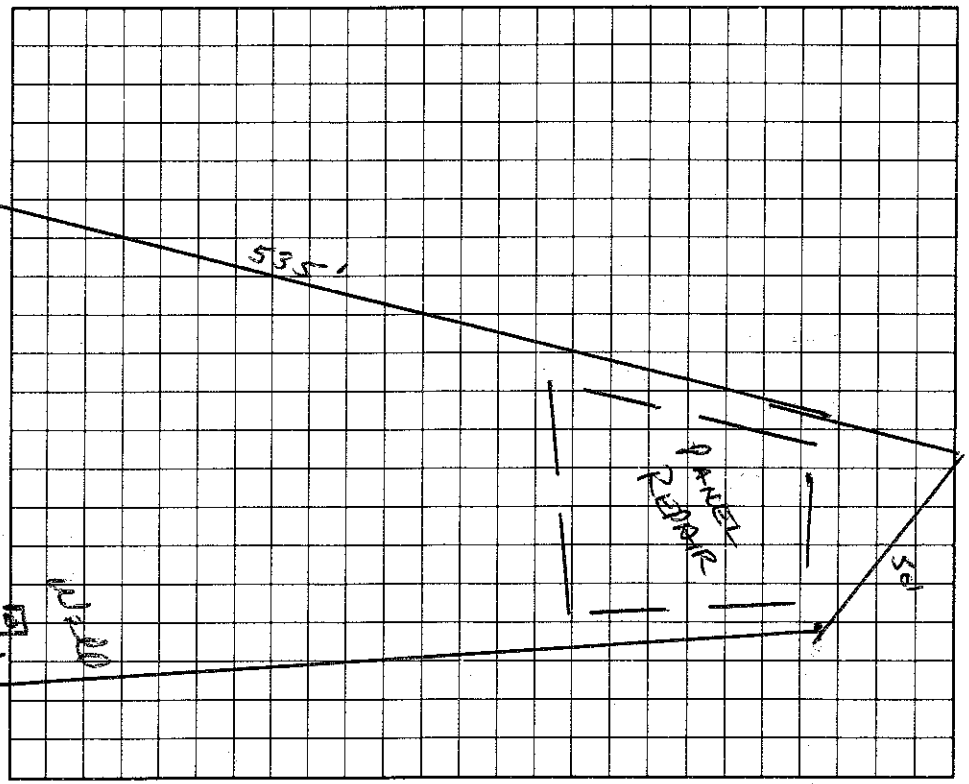

I understand that this permit can be suspended or revoked if any false information is supplied toward securing the permit/any unauthorized changes are made to the site/any unauthorized changes are made in the installation of the system.

Authorization to Construct valid 60 months.

Signed: X Gary D. Ford

Improvement Permit by: Wesley Sparks RS. date 6/12/96

Existing System Inspection by: Wesley Sparks RS date 6/12/96

Installed by: Wayne Mowery.

Certificate of Completion by: date

Operation Permit by: Wesley Sparks RS. date 11/12/96

HEALTH DEPT. COPY: WHITE INSPECTION COPY (FINAL): GREEN OWNER COPY (FINAL): YELLOW INSPECTION COPY (INITIAL): PINK OWNER COPY (INITIAL): GOLD