IREDELL COUNTY HEALTH DEPARTMENT

STATESVILLE 704-878-5305 MOORESVILLE 704-664-528

IMPROVEMENT PERMIT / AUTHORIZATION TO CONSTRUCT / OPERATION PERMIT / EXISTING SYSTEM INSPECTION

PERMIT# 092031 PIN# 4370 77 87 5.

OWNER OR CONTRACTOR Van Edward Conta PHONE: Business _____ DATE 9/29/00

ADDRESS 150 Rocky River Rd. Mooresville, NC. 28115 Home ~~664-7868~~ 799-7528

LOCATION 150 W. Quiet Cove Rd. L Hollingwood on (R) # 142

SUBDIVISION Spring Cove BLOCK / SECTION 2 LOT 046 LOT AREA .44 AC. SITE CLASS. P5 DESIGN FLOW 360 L.T.A.R. .3

Septic Tank: EXISTING Gallons; STB _____ Date _____

Pump Tank: _____ Gallons; PT _____ Date _____

Pump Make: _____ Model _____ Serial No. _____

Nitrification Field: No Fields 1 Square Feet 200 Linear Feet 200

No Lines 4 Trench Width 14" Max Trench Bottom Depth 36" Gravel Depth SAND.

☐ New System ☐ Repair System Type: I, II, (III) IV, V, VI

System Description: EXISTING SYSTEM

Repair System Description: _____

Maintenance Agreement Required: ☐ Yes ☒ No

☒ House/Mod. Home No. Bedrooms 3

☐ Mobile Home No. Bathrooms 3

☐ Business No. Employees ____

☐ Other _____

☐ Slab ☒ Crawl Space ☐ Basement w/plumbing ☐ Basement wo/plumbing


Water Supply: ☒ Individual ☐ Public ☐ Community

Comments:/Conditions:

Comments:/Conditions:

INITIAL SITE SKETCH

AS BUILT SKETCH

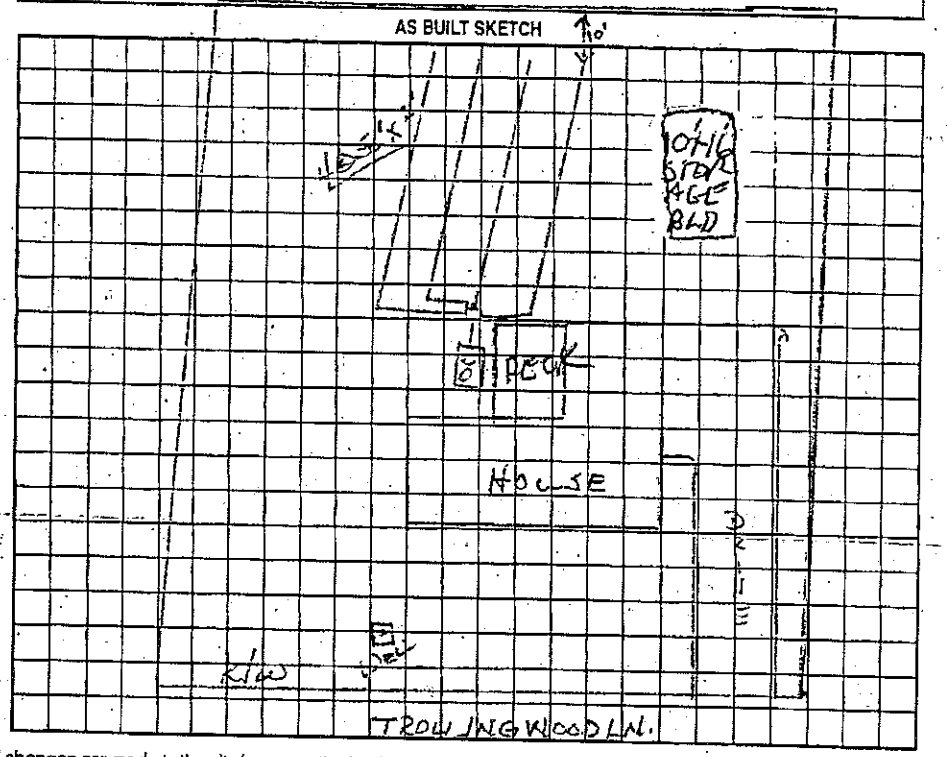

Permit can be suspended or revoked if any false information is supplied toward securing the permit/any unauthorized changes are made to the site/any unauthorized changes are made in the installation of the system. Improvement Permit with plat valid without expiration. Improvement Permit with site plan valid for sixty months. Authorization to Construct is valid for a period equal to that of Improvement Permit – not to exceed sixty months.

Signed: _____ date _____ Installed by: _____

Improvement Permit by: _____ date _____ Operation Permit by: _____ date _____

Authorization to Construct by: _____ date _____ Existing System Inspection by: Wesley Sparks R.S. date 9/29/00

HEALTH DEPT. COPY: WHITE OWNER COPY (FINAL): YELLOW OWNER COPY (INITIAL): PINK