4637077946

IREDELL COUNTY HEALTH DEPARTMENT

STATESVILLE 704-878-5305 MOORESVILLE 704-664-5281

IMPROVEMENT PERMIT / CERTIFICATE OF COMPLETION / OPERATION PERMIT / EXISTING SYSTEM INSPECTION

PROPERTY DESCRIPTION NO. 16892 DATE Oct. 25, 94 TAX MAP NO. 2L7045 Watershed: ☑ Yes ☐ No LN WS III

OWNER OR CONTRACTOR James Mg Harper PHONE: Business (704) 478-3766 Home

ADDRESS 1651 Lake Front Dr, Catawba, NC 28609

LOCATION 150 W. To Quiet Cove Rd. R. Fallingwood Lane on Rt

SUBDIVISION Spring Acres BLOCK / SECTION LOT 45 LOT AREA 110'x480' SITE CLASS. PS pw/95 DESIGN FLOW 360gpd L.T.A.R. .25

Septic Tank: 1000 Gallons; STB T85 Straight Date 3-21-95

Pump Tank: Gallons; PT Date

Pump Make: Model Serial No.

Nitrification Field: No Fields 2 Square Feet 1440 Linear Feet 480

No Lines 4+4 Trench Width 36" Max Trench Bottom Depth 24" Gravel Depth 12"

☑ New System ☐ Repair System Type: I, II, III, IV, V, VI

System Description: gravity conventional & PPBFS

Repair System Description:

Maintenance Agreement Required: ☐ Yes ☑ No

☑ House/Mod. Home No. Bedrooms 3

☐ Mobile Home No. Bathrooms 2

☐ Business No. Employees

☐ Other


☑ Slab ☐ Crawl Space ☐ Basement w/plumbing ☐ Basement wo/plumbing

Water Supply: ☑ Individual ☐ Community ☐ Public

Comments:

Comments: Installed as shown

INITIAL SITE SKETCH

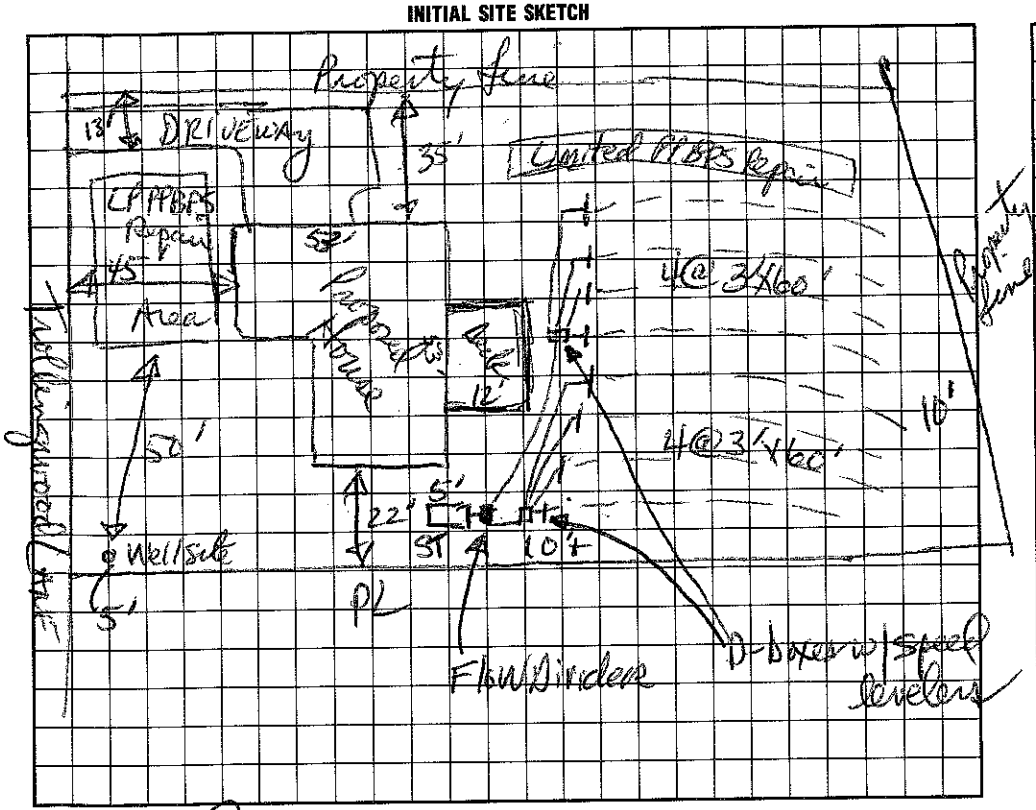

AS BUILT SKETCH

I understand that this permit can be suspended or revoked if any false information is supplied toward securing the permit/any unauthorized changes are made to the site/any unauthorized changes are made in the installation of the system. Improvement Permit is valid for 60 months from date of issuance.

Signed: James M. Harper

Improvement Permit by: Mark D. Hanson, RS date 10/25/94

Existing System Inspection by: date

Installed by: Kennedy Harding & Newton

Certificate of Completion by: Mark D. Hanson, RS date 4/19/95

Operation Permit by: date

HEALTH DEPT. COPY: WHITE INSPECTION COPY (FINAL): GREEN OWNER COPY (FINAL): YELLOW INSPECTION COPY (INITIAL): PINK OWNER COPY (INITIAL): GOLD