2100

IREDELL COUNTY HEALTH DEPARTMENT

STATESVILLE 704-878-5305 MOORESVILLE 704-664-5281

IMPROVEMENT PERMIT / AUTHORIZATION TO CONSTRUCT / OPERATION PERMIT / EXISTING SYSTEM INSPECTION

PERMIT# 149960 PIN# 4637107261 DATE 6/23/08

OWNER OR APPLICANT Andrew Ievalone PHONE: Business 704.746.8634 Home same

ADDRESS 137 Boston Path Rd.

LOCATION Brawley School Rd., TR Blume, TL Boston Path, on Left

SUBDIVISION — BLOCK / SECTION — LOT — LOT AREA 3.393 acres SITE CLASS. P.S. DESIGN FLOW 300 gal/day T.A.R. 0.3

Septic Tank: 1000 Gallons; STB 312 Date 11-3-09

Pump Tank: 1000 Gallons; PT 8822283 Date 10-30-09

Pump Make: HYDROMATIC Model SHEF45M1 Serial No. 3/4 HP

Nitrification Field: No Fields 1 Square Feet 1200' Linear Feet 300'

No Lines 4 Trench Width 36" Max Trench Bottom Depth 36" Gravel Depth — ☐ Gravity ☑ Pressure

☑ New System ☐ Repair ☐ Expansion System Type: I II (III) IV V VI

System Description: pump 25%

Repair System Description: LPPBPS

Maintenance Agreement Required: ☐ Yes ☑ No

☐ House/Mod. Home No. Bedrooms —

☐ Mobile Home No. Persons —

☐ Business No. Employees —

☐ Other —

Water Supply: ☑ Individual ☐ Public ☐ Community


☐ Slab ☐ Crawl Space ☑ Basement w/plumbing ☐ Basement wo/plumbing

Comments:/Conditions:

* install on contour, maintain all setbacks
* Tanks 10' ~~from~~ downslope from daylight basement
* Tanks 15' from pool, supply line at least 10' from pool

Comments:/Conditions:

INITIAL SITE SKETCH not to scale

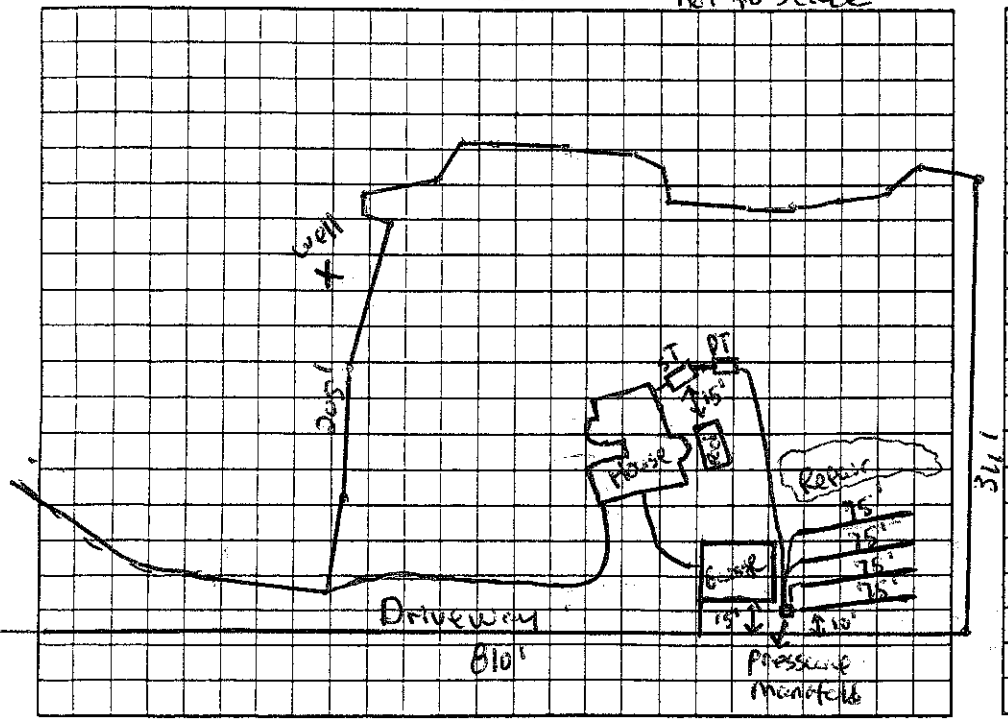

AS BUILT SKETCH

Permit can be suspended or revoked if any false information is supplied toward securing the permit/any unauthorized changes are made to the site/any unauthorized changes are made in the installation of the system. Improvement Permit with plat valid without expiration ☐ Improvement Permit with site plan valid for sixty months ☑ Authorization to Construct is valid for a period equal to that of Improvement Permit – not to exceed sixty months.

Signed: [signature] date 6/23/08 Installed by: Richard Abernathy

Improvement Permit by: Randy Moore date 6/23/08 Operation Permit by: [signature] REHS date 1-28-10

Authorization to Construct by: Randy Moore date 6/23/08 Existing System Inspection by: — date —

HEALTH DEPT. COPY: WHITE OWNER COPY (FINAL): YELLOW OWNER COPY (INITIAL): PINK