IREDELL COUNTY HEALTH DEPARTMENT

STATESVILLE 704-878-5305 MOORESVILLE 704-664-5281

IMPROVEMENT PERMIT / AUTHORIZATION TO CONSTRUCT / OPERATION PERMIT / EXISTING SYSTEM INSPE...

PERMIT# 111768 PIN# 4637122391.4 4637113954 DATE 4/25/03

OWNER OR CONTRACTOR MIBLOCK DEVELOPMENT PHONE: Business 331-4785 Home

ADDRESS 300 McGILL AVE. NW CONCORD, NC 28027

LOCATION BRAWLEY SCHOOL - TR BLUME - TL BEATEN PATH - TR CULPEZE - ON RT

SUBDIVISION EDGEWATER PARK BLOCK / SECTION LOT 4 LOT AREA 1.85+Ac SITE CLASS. PS DESIGN FLOW 480GPD L.T.A.R. .30 OF 1FT2

Septic Tank: 1000 Gallons; STB 794 Date 3/25/03

Pump Tank: 1000 Gallons; PT 29 Date

Pump Make: ZOELLER Model N-98 Serial No.

Nitrification Field: No Fields 1 Square Feet 1200 Linear Feet 400

No Lines 4@100' Trench Width 36" Max Trench Bottom Depth 36" Gravel Depth N/A

☑ New System ☐ Repair System Type: I, II, III, IV, V, VI

System Description: PUMP 25% REDUCTION

Repair System Description: LP 25% REDUCTION

Maintenance Agreement Required: ☐ Yes ☑ No

☑ House/Mod. Home No. Bedrooms 4

☐ Mobile Home No. Bathrooms 4

☐ Business No. Employees

☐ Other


☐ Slab ☑ Crawl Space ☐ Basement w/plumbing ☐ Basement wo/plumbing

Water Supply: ☑ Individual ☐ Public ☐ Community

Comments:/Conditions: ~~X~~ DO NOT CUT HOUSE PAD~~A~~

Comments:/Conditions: EZ FLOW INSTALLED

INITIAL SITE SKETCH 1"=50'

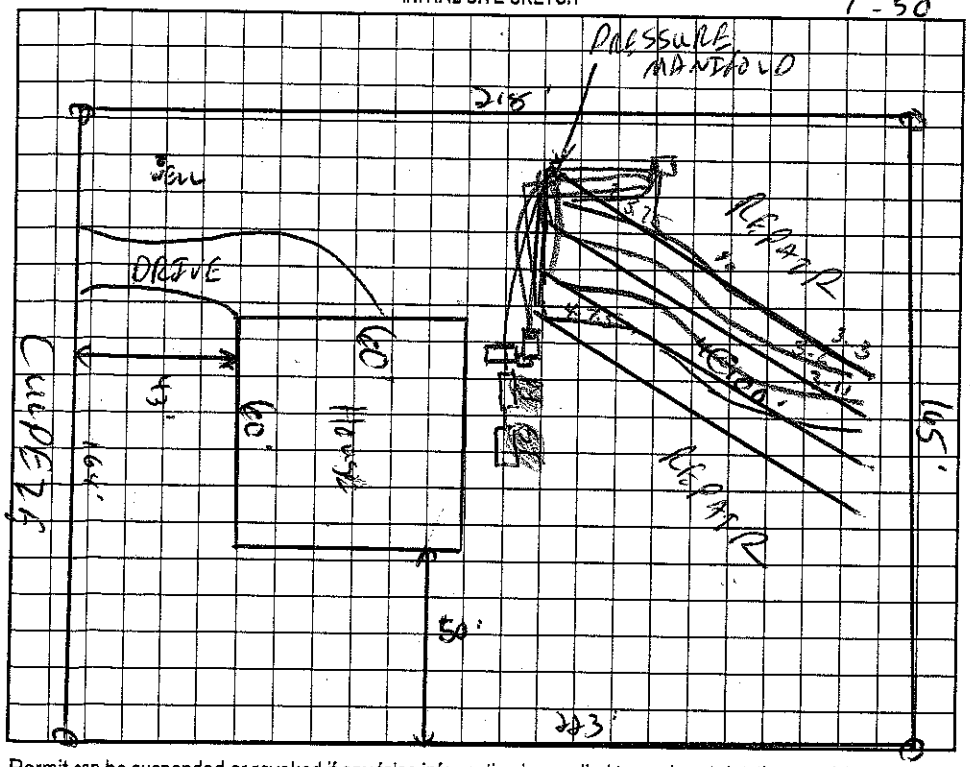

AS BUILT SKETCH

Permit can be suspended or revoked if any false information is supplied toward securing the permit/any unauthorized changes are made to the site/any unauthorized changes are made in the installation of the system. Improvement Permit with plat valid without expiration. Improvement Permit with site plan valid for sixty months. Authorization to Construct is valid for a period equal to that of Improvement Permit – not to exceed sixty months.

Signed: Pat Carpenter date 4/30/03

Improvement Permit by: C. Hyatt RS date 4/25/03

Authorization to Construct by: C. Hyatt RS date 4/29/03

Installed by: Jerry Watts

Operation Permit by: RS date 5/9/03

Existing System Inspection by: date

HEALTH DEPT. COPY: WHITE OWNER COPY (FINAL): YELLOW OWNER COPY (INITIAL): PINK