IREDELL COUNTY HEALTH DEPARTMENT

STATESVILLE 704-878-5305 MOORESVILLE 704-664-5281

IMPROVEMENT PERMIT / AUTHORIZATION TO CONSTRUCT / OPERATION PERMIT / EXISTING SYSTEM INSPECTION

PERMIT# 111737 PIN# 4637128391.3 4637114757 DATE 4/25/03

OWNER OR CONTRACTOR NIBLOCK DEVELOPMENT PHONE: Business 331-4745 Home

ADDRESS 300 McBELL AVE NW CONCORD NC 28027

LOCATION BRADLEY SCHOOL - TR BLUME - TL BEATEN PATH - TR CULPEPER - ON RT

SUBDIVISION EDGEWATER PARK BLOCK / SECTION LOT 3 LOT AREA 1.142 AC SITE CLASS. PS DESIGN FLOW 480GPD L.T.A.R. ~.3600 GPD

Septic Tank: 1000 Gallons; STB 794 Date 6-17-03

Pump Tank: ~~1000~~ Gallons; PT Date

Pump Make: Model Serial No.

Nitrification Field: No Fields 1 Square Feet 600 Linear Feet 300

No Lines 6@50' Trench Width 24 or 36" Max Trench Bottom Depth 30" Gravel Depth N/A

☑ New System ☐ Repair System Type: I, II, III, IV, V, VI

System Description: PUMP PANEL

Repair System Description: LP PANEL

Maintenance Agreement Required: ☐ Yes ☑ No

☑ House/Mod. Home ☐ Mobile Home ☐ Business ☐ Other

No. Bedrooms 4 No. Bathrooms 4 No. Employees


Water Supply: ☑ Individual ☐ Public ☐ Community

☐ Slab ☑ Crawl Space ☐ Basement w/plumbing ☐ Basement wo/plumbing


Comments:/Conditions: SURFACE SWALE AND FRENCH DRAIN INSTALLED ABOVE SYSTEM AND REPAIR. FRENCH DRAIN TO BE INSTALLED 48" DEEP AND DRAINED OUT TO ROAD.

Comments:/Conditions: → TRENCHES MAY BE INSTALLED 36" IN WIDTH. 24" trench, set ST so gravity flow to drainfield

INITIAL SITE SKETCH

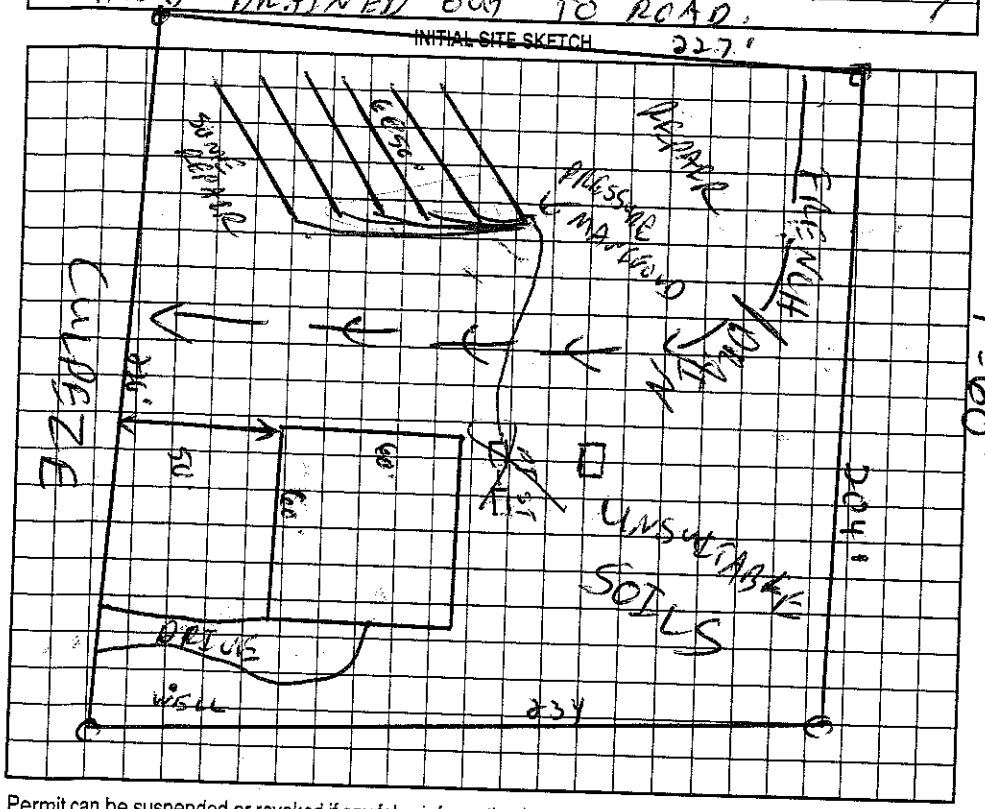

AS BUILT SKETCH

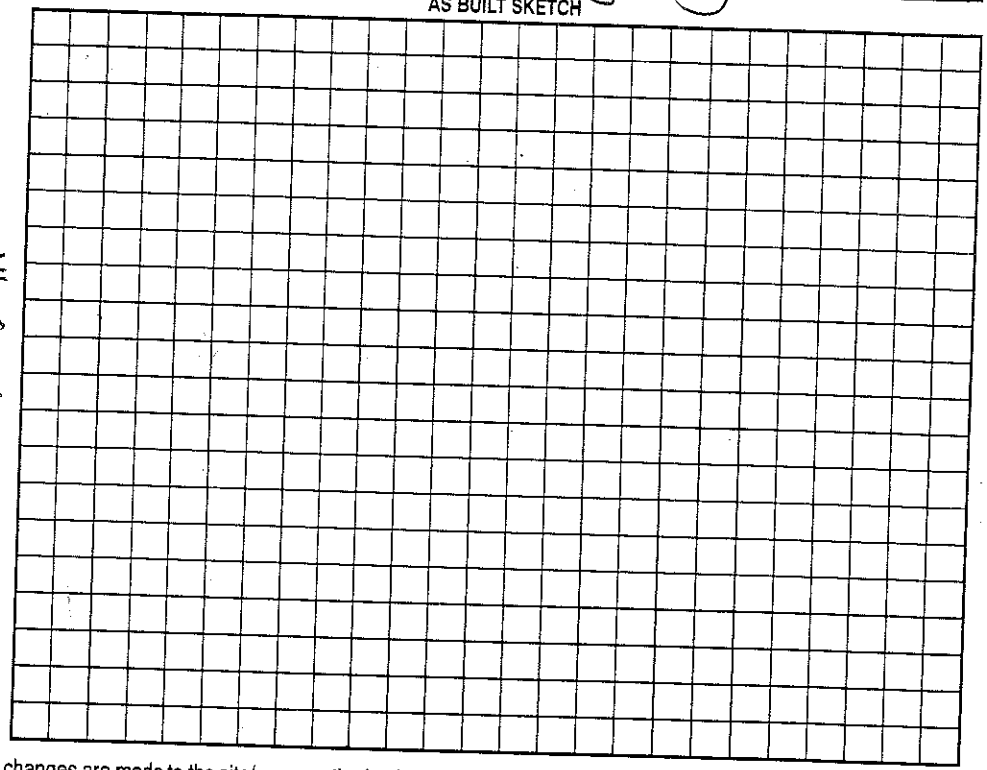

Permit can be suspended or revoked if any false information is supplied toward securing the permit/any unauthorized changes are made to the site/any unauthorized changes are made in the installation of the system. Improvement Permit with plat valid without expiration. Improvement Permit with site plan valid for sixty months. Authorization to Construct is valid for a period equal to that of Improvement Permit – not to exceed sixty months.

Signed: Pat Carpenter date 4/30/03 Installed by: Commercial Services

Improvement Permit by: C. Lyon RS date 4/25/03 Operation Permit by: Gene Mullis RS date 9/3/03

Authorization to Construct by: C. Lyon RS date 4/30/03 Existing System Inspection by: date

HEALTH DEPT. COPY: WHITE OWNER COPY (FINAL): YELLOW OWNER COPY (INITIAL): PINK