4.00

IREDELL COUNTY HEALTH DEPARTMENT

STATESVILLE 704-878-5305 MOORESVILLE 704-664-5281

IMPROVEMENT PERMIT / AUTHORIZATION TO CONSTRUCT / OPERATION PERMIT / EXISTING SYSTEM INSPECTION

PERMIT# 11735 PIN# 4637-12-2391.2 4637-11-5569 DATE 4/25/03

OWNER OR CONTRACTOR NIBLOCK DEVELOPMENT PHONE: Business 331-4745 Home

ADDRESS 300 MCGILL AVE. NW CONCORD, NC 28027

LOCATION BRAWLEY SCHOOL - TR BLUME TL BEATEN PATH - TR CULPEZE - 2nd ON RT

SUBDIVISION EDGEWATER PARK BLOCK / SECTION LOT 2 LOT AREA 1.12AC SITE CLASS. PS DESIGN FLOW 480GPD L.T.A.R. .3680/R12

Septic Tank: 1000 Gallons; STB 794 Date 11-13-03
Pump Tank: 1000 Gallons; PT 283 Date 1-6-04
Pump Make: LittleGiant Model 901+ Serial No.
Nitrification Field: No Fields 1 Square Feet 1200 Linear Feet 400
No Lines 5 Trench Width 36" Max Trench Bottom Depth 36" Gravel Depth N/A


☑ New System ☐ Repair System Type: I, II, (III), IV, V, VI
System Description: PUMP 25% REDUCTION
Repair System Description: LP PANEL
Maintenance Agreement Required: ☐ Yes ☑ No

☑ House/Mod. Home No. Bedrooms 4
☐ Mobile Home No. Bathrooms 4
☐ Business No. Employees
☐ Other
☐ Slab ☑ Crawl Space ☐ Basement w/plumbing ☐ Basement wo/plumbing

Water Supply: ☑ Individual ☐ Public ☐ Community

Comments:/Conditions:

INITIAL SITE SKETCH

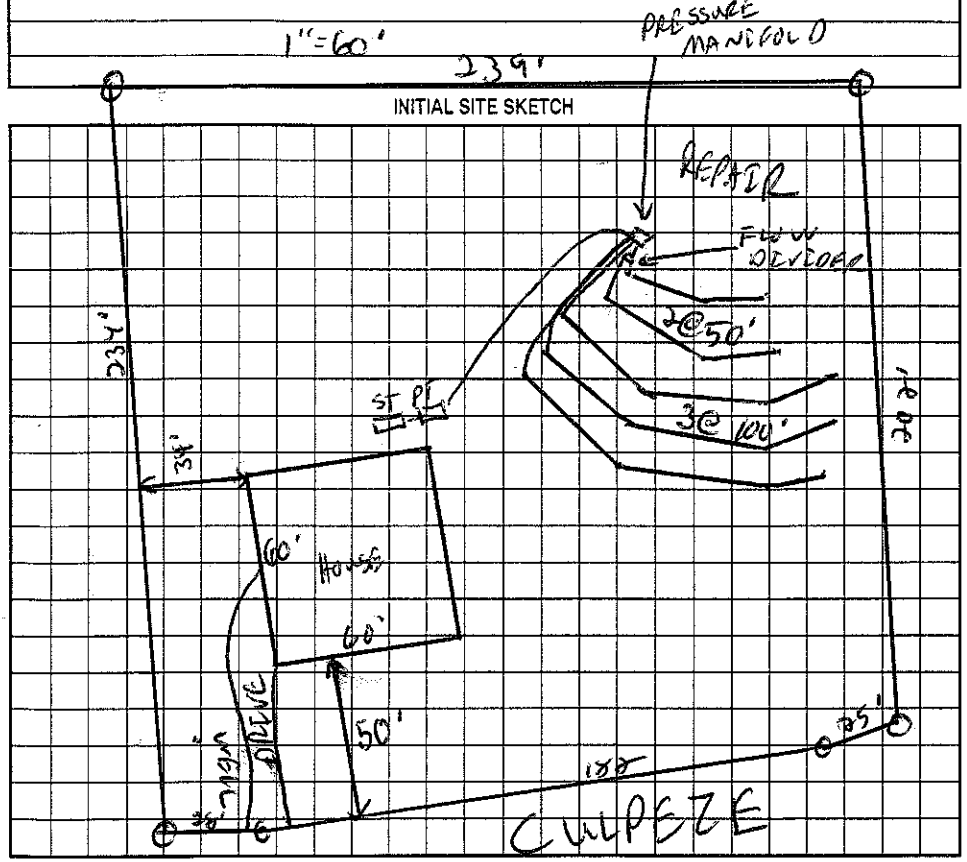

Comments:/Conditions: Checked tanks & lines 2/24/04
Blue Polylok filter installed
Checked pressure, elect & alarm 3/19/04

AS BUILT SKETCH

Used 11" Plastic Chambers for Drain Field (Installed as Drawn)

Permit can be suspended or revoked if any false information is supplied toward securing the permit/any unauthorized changes are made to the site/any unauthorized changes are made in the installation of the system. Improvement Permit with plat valid without expiration. Improvement Permit with site plan valid for sixty months. Authorization to Construct is valid for a period equal to that of Improvement Permit – not to exceed sixty months.

Signed: Pat Carpenter date 4/30/03
Improvement Permit by: [signature] RS date 4/25/03
Authorization to Construct by: Wesley Sparks RS date 12/4/03

Installed by: Richard Abernathy RS
Operation Permit by: Mark Dotson RS date 3/19/04
Existing System Inspection by: date

HEALTH DEPT. COPY: WHITE OWNER COPY (FINAL): YELLOW OWNER COPY (INITIAL): PINK