IREDELL COUNTY HEALTH DEPARTMENT

STATESVILLE 704-878-5305 MOORESVILLE 704-664-5281

IMPROVEMENT PERMIT / AUTHORIZATION TO CONSTRUCT / OPERATION PERMIT / EXISTING SYSTEM INSPECTIO

PERMIT# 11732 PIN# 4637122391.1 4637-11-7457 DATE 4/25/03

OWNER OR CONTRACTOR NIBLOCK DEVELOPMENT PHONE: Business 331-4745 Home

ADDRESS 300 McGILL AVE NW CONCORD, NC 28027

LOCATION BRAWLEY SCHOOL - TR BLUME - TL BEATEN PATH - TR CULPEPPER - ON RT CORNER

SUBDIVISION EDGEWATER PARK BLOCK / SECTION LOT 1 LOT AREA 39,399 ft² SITE CLASS. PS DESIGN FLOW 480GPD L.T.A.R. .3000/ft²

Septic Tank: 1000 Gallons; STB 794 Date 5/11/04
Pump Tank: 1000 Gallons; PT 283 Date 7/3/04
Pump Make: Model Serial No.
Nitrification Field: No Fields 1 Square Feet 1200 Linear Feet 400
No Lines 4 Trench Width 36" Max Trench Bottom Depth 36" Gravel Depth N/A

☑ New System ☐ Repair System Type: I, II, (III), IV, V, VI
System Description: PUMP 25% REDUCTION
Repair System Description: LP PANEL
Maintenance Agreement Required: ☐ Yes ☑ No

☑ House/Mod. Home No. Bedrooms 4
☐ Mobile Home No. Bathrooms 4
☐ Business No. Employees
☐ Other


☐ Slab ☑ Crawl Space ☐ Basement w/plumbing ☐ Basement wo/plumbing

Water Supply: ☑ Individual ☐ Public ☐ Community


Comments:/Conditions:

Comments:/Conditions:

INITIAL SITE SKETCH 1"=50'

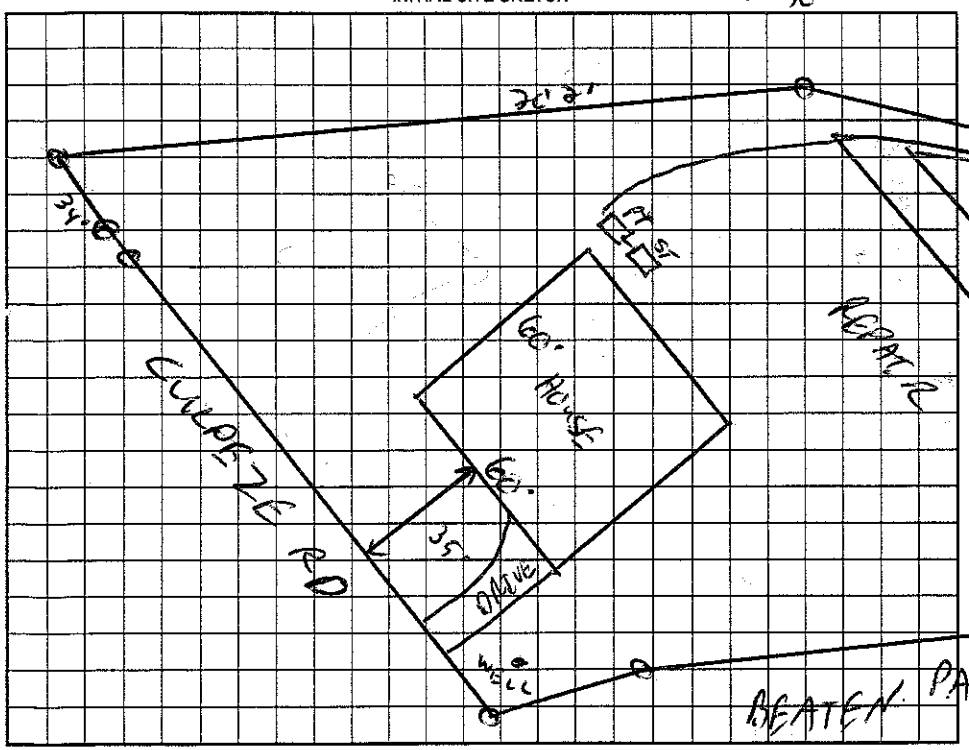

AS BUILT SKETCH

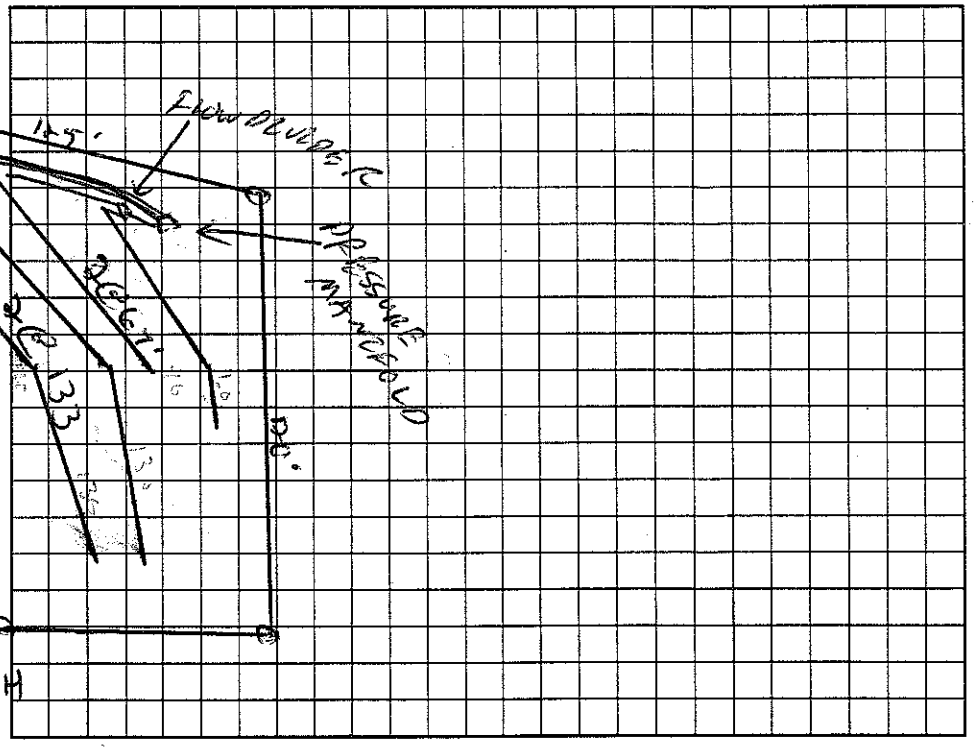

Permit can be suspended or revoked if any false information is supplied toward securing the permit/any unauthorized changes are made to the site/any unauthorized changes are made in the installation of the system. Improvement Permit with plat valid without expiration. Improvement Permit with site plan valid for sixty months. Authorization to Construct is valid for a period equal to that of Improvement Permit – not to exceed sixty months.

Signed: Pat Carpenter date 4/30/03 Installed by: Richard Blumenthy

Improvement Permit by: RS date 4/25/03 Operation Permit by: RS date 9/16/04

Authorization to Construct by: RS date 4/28/04 Existing System Inspection by: date

HEALTH DEPT. COPY: WHITE OWNER COPY (FINAL): YELLOW OWNER COPY (INITIAL): PINK