3:30

IREDELL COUNTY HEALTH DEPARTMENT

STATESVILLE 704-878-5305 MOORESVILLE 704-664-5281

IMPROVEMENT PERMIT / AUTHORIZATION TO CONSTRUCT / OPERATION PERMIT / EXISTING SYSTEM INSPECTION

PERMIT# 115666 PIN# ~~4637-12-2391-0000~~ 4637-11-7738 DATE 10/7/03

OWNER OR CONTRACTOR NIBLOCK DEVELOPMENT CORP PHONE: Business 788-4818 Home

ADDRESS 300 McGILL AVE. CONCORD NC 28025

LOCATION BRAWLEY SCHOOL - TR BLUME - ON LT

SUBDIVISION EDGEWATER PK BLOCK / SECTION 2 LOT 18 LOT AREA .185AC SITE CLASS. RS DESIGN FLOW 450GPD L.T.A.R. .3000/FT²

Septic Tank: 1000 Gallons; STB 312 Date 5/10/04
Pump Tank: ____ Gallons; PT ____ Date ____
Pump Make: ____ Model ____ Serial No. ____
Nitrification Field: No Fields 1 Square Feet 1200 Linear Feet 400
No Lines 3 @ 133' Trench Width 36" Max Trench Bottom Depth 36" Gravel Depth N/A

☑ New System ☐ Repair System Type: I, II, (III), IV, V, VI
System Description: GRAVITY 25% REDUCTION
Repair System Description: LP PANEL
Maintenance Agreement Required: ☐ Yes ☑ No


☑ House/Mod. Home No. Bedrooms 4
☐ Mobile Home No. Bathrooms 4
☐ Business No. Employees ____
☐ Other ____
☐ Slab ☑ Crawl Space ☐ Basement w/plumbing ☐ Basement wo/plumbing

Water Supply: ☑ Individual ☐ Public ☐ Community

Comments:/Conditions:

Comments:/Conditions:

INITIAL SITE SKETCH 1"=50'

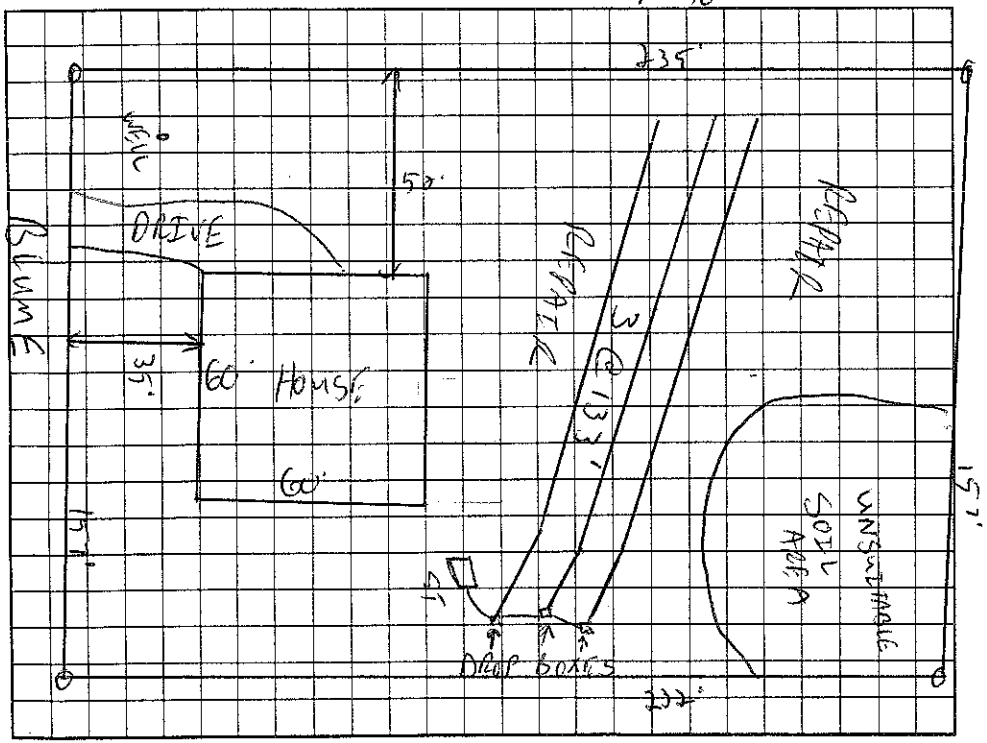

AS BUILT SKETCH

Infiltrators Installed

Permit can be suspended or revoked if any false information is supplied toward securing the permit/any unauthorized changes are made to the site/any unauthorized changes are made in the installation of the system. Improvement Permit with plat valid without expiration. Improvement Permit with site plan valid for sixty months. Authorization to Construct is valid for a period equal to that of Improvement Permit – not to exceed sixty months.

Signed: Pat Carpenter date 10/14/03 Installed by: Abernathy

Improvement Permit by: ____ RS date 10/7/03 Operation Permit by: ____ RS date 8/6/04

Authorization to Construct by: ____ RS date 7/12/04 Existing System Inspection by: ____ date ____

HEALTH DEPT. COPY: WHITE OWNER COPY (FINAL): YELLOW OWNER COPY (INITIAL): PINK