IREDELL COUNTY HEALTH DEPARTMENT

STATESVILLE 704-878-5305 245.00 Paid MOORESVILLE 704-664-5281

IMPROVEMENT PERMIT / AUTHORIZATION TO CONSTRUCT / OPERATION PERMIT / EXISTING SYSTEM INSPECTION

PERMIT# 111770 PIN# ~~4637-13-2947.6~~ 4637121285.000 DATE 7/11/03

OWNER OR CONTRACTOR Niblock Dev. PHONE: Business 704-531-4745 Home

ADDRESS 300 McGill Av NW Concord, NC 28027

LOCATION BSR, TR Blume, TL Beaton Park, TR Culpeze on Rt

SUBDIVISION Edgewater PK BLOCK / SECTION LOT 6 LOT AREA 1.059 AC SITE CLASS. PS DESIGN FLOW 480 L.T.A.R. 0-3

Septic Tank: 1000 Gallons; STB 794 Date 4/29/03
Pump Tank: 1000 Gallons; PT 253 Date 6/4/03
Pump Make: ZOELLER Model ~~N264~~ N140 Serial No.
Nitrification Field: No Fields 1 Square Feet 1200 Linear Feet 400
No Lines 7 Trench Width 36" Max Trench Bottom Depth 36" Gravel Depth —

☒ New System ☐ Repair System Type: I, II, III, (IV), V, VI
System Description: LP 25% Reduction
Repair System Description: LP Panel Block
Maintenance Agreement Required: ☒ Yes ☐ No


☒ House/Mod. Home No. Bedrooms 4
☐ Mobile Home No. Bathrooms 4
☐ Business No. Employees
☐ Other
☐ Slab ☒ Crawl Space ☐ Basement w/plumbing ☐ Basement wo/plumbing

Water Supply: ☒ Individual ☐ Public ☐ Community

Comments:/Conditions: Space holes 5' apart + Turn holes up

Comments:/Conditions:

INITIAL SITE SKETCH

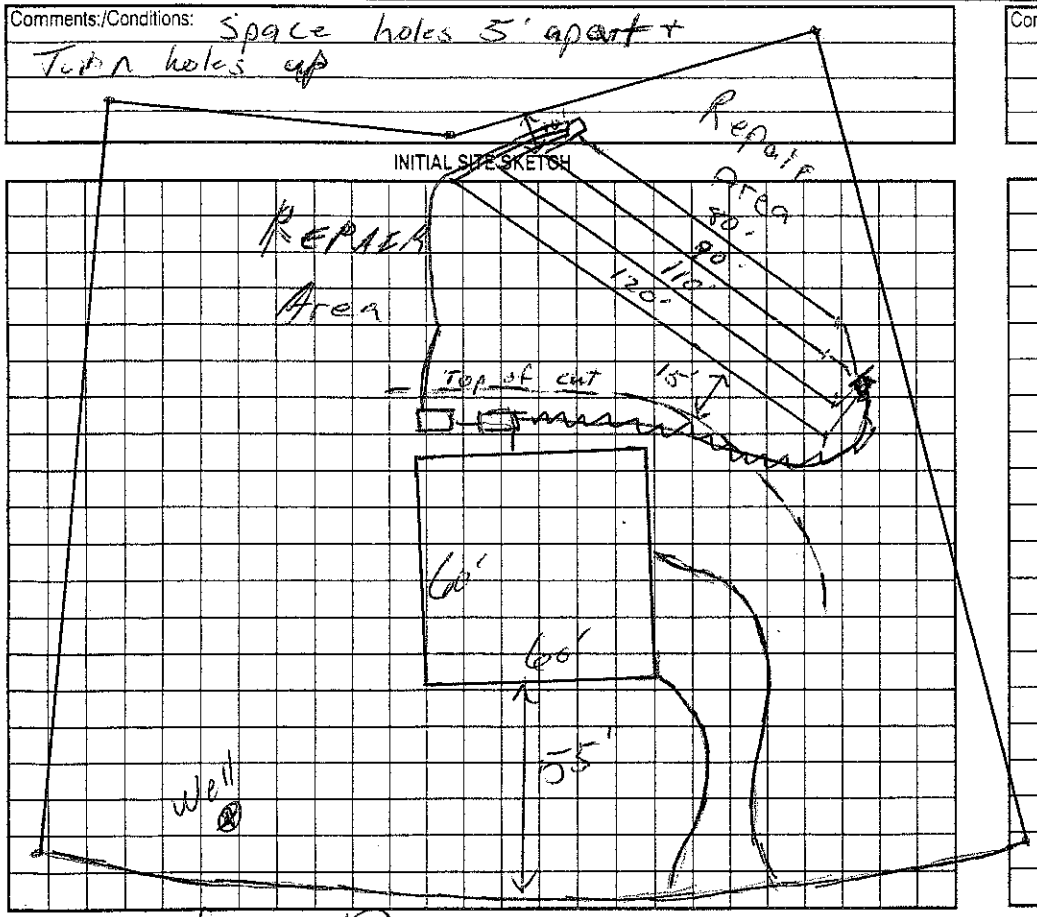

AS BUILT SKETCH

EZ Flow Installed As Drawn

Permit can be suspended or revoked if any false information is supplied toward securing the permit/any unauthorized changes are made to the site/any unauthorized changes are made in the installation of the system. Improvement Permit with plat valid without expiration. Improvement Permit with site plan valid for sixty months. Authorization to Construct is valid for a period equal to that of Improvement Permit – not to exceed sixty months.

Signed: date 7-14-03 Installed by: Commercial Services of Stem Field

Improvement Permit by: RS date 7/11/03 Operation Permit by: RS date 8/18/03

Authorization to Construct by: RS date 7/11/03 Existing System Inspection by: date

HEALTH DEPT COPY: WHITE OWNER COPY (FINAL): YELLOW OWNER COPY (INITIAL): PINK