4:30

IREDELL COUNTY HEALTH DEPARTMENT

STATESVILLE 704-878-5305 MOORESVILLE 704-664-5281

IMPROVEMENT PERMIT / AUTHORIZATION TO CONSTRUCT / OPERATION PERMIT / EXISTING SYSTEM INSPECTION

PERMIT# 111795 PIN# 463712 2391,8 4637-12-1603 DATE 4/28/03

OWNER OR CONTRACTOR NIBLOCK DEVELOPMENT PHONE: Business 331-4745 Home

ADDRESS 300 MCGILL AVE. NW CONCORD NC 28027

LOCATION BRAWLEY SCHOOL - TR BLUME - TL BEATEN PATH - TR CULPEPPER - 8TH ON RT

SUBDIVISION EDGEWATER PARK BLOCK / SECTION LOT 8 LOT AREA .735 SITE CLASS. PS DESIGN FLOW 480.00 L.T.A.R. .30 P0/P2

Septic Tank: 1000 Gallons; STB 312 Date 11-10-03

Pump Tank: 1000 Gallons; PT Date 1-12-04

Pump Make: Model Serial No.

Nitrification Field: No Fields 1 Square Feet 1000 Linear Feet 400

No Lines 6@67' Trench Width 36" Max Trench Bottom Depth 36" Gravel Depth N/A

☑ New System ☐ Repair System Type: I, II, III, IV, V, VI

System Description: Pump 2506 Reduction LP PANEL

Repair System Description:

Maintenance Agreement Required: ☐ Yes ☑ No

☑ House/Mod. Home No. Bedrooms 4

☐ Mobile Home No. Bathrooms 4

☐ Business No. Employees

☐ Other


☐ Slab ☑ Crawl Space ☐ Basement w/plumbing ☐ Basement wo/plumbing

Water Supply: ☐ Individual ☐ Public ☐ Community

Comments:/Conditions: DO NOT CUT FOR HOUSE - MAY BE CHANGED TO GRAVITY AFTER HOUSE IS IN PLACE. CONSULT WITH HEALTH DEPARTMENT BEFORE DOING SO.

Comments:/Conditions Checked tanks & lines 2/23/04 MP

INITIAL SITE SKETCH 1" = 50'

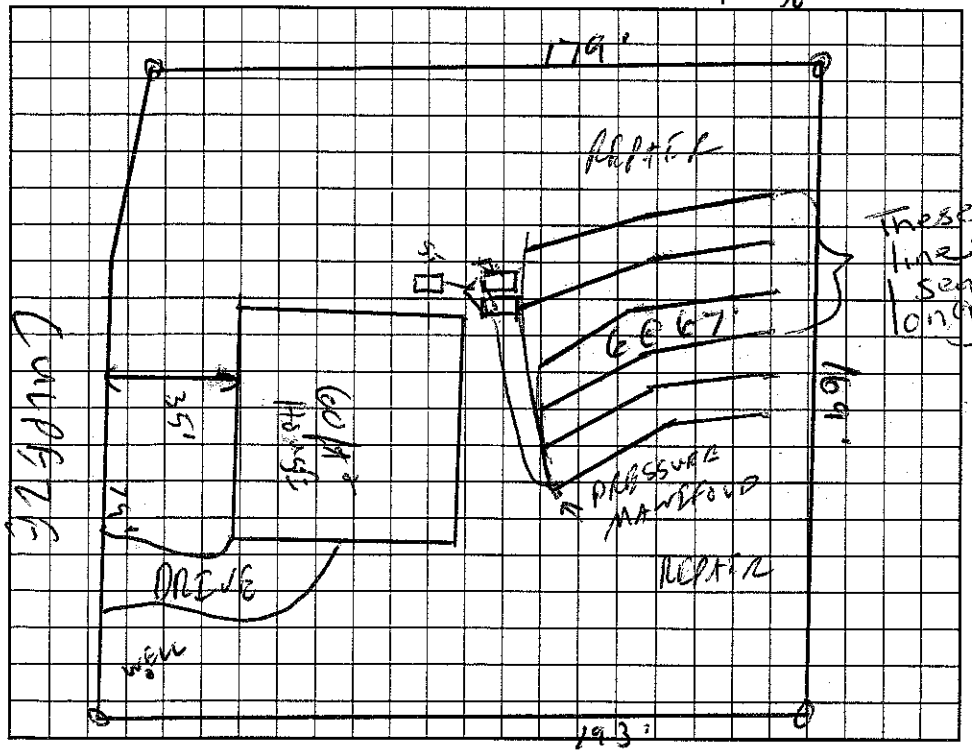

AS BUILT SKETCH

Installed "Plastic Chambers" For Drainfield

Permit can be suspended or revoked if any false information is supplied toward securing the permit/any unauthorized changes are made to the site/any unauthorized changes are made in the installation of the system. Improvement Permit with plat valid without expiration. Improvement Permit with site plan valid for sixty months. Authorization to Construct is valid for a period equal to that of Improvement Permit – not to exceed sixty months.

Signed: Pat Carpenter date 4/30/03 Installed by: Richard Abernathy

Improvement Permit by: C. [illegible] RS date 4/28/03 Operation Permit by: Maria [illegible] date 3/19/04

Authorization to Construct by: Wesley Sparks RS date 12/4/03 Existing System Inspection by: date

HEALTH DEPT. COPY: WHITE OWNER COPY (FINAL): YELLOW OWNER COPY (INITIAL): PINK