# IREDELL COUNTY HEALTH DEPARTMENT

STATESVILLE 704-878-5305 MOORESVILLE 704-664-5281

## IMPROVEMENT PERMIT / AUTHORIZATION TO CONSTRUCT / OPERATION PERMIT / EXISTING SYSTEM INSPECTION

PERMIT# 120872 PIN# 4637-12-1802 DATE 6/7/04

OWNER OR CONTRACTOR Jim + Shirley Rogers / Carter Blades PHONE: Business 704-699-4480 Home

ADDRESS 141 Sulpeace Rd. Mooresville NC 28117

LOCATION BSR TR Blume, TL Boaten Path, TR Culpeeze on Rt

SUBDIVISION Edgewater PK BLOCK / SECTION LOT 9 LOT AREA 0.772 Ac SITE CLASS. PS DESIGN FLOW 440 L.T.A.R. 0.85

Septic Tank: Existing Gallons; STB Date

Pump Tank: Existing Gallons; PT Date

Pump Make: Model Serial No.

Nitrification Field: No Fields 1 Square Feet 640 Linear Feet 320

No Lines 4 Trench Width 24" Max Trench Bottom Depth 40" Gravel Depth —

☐ New System ☐ Repair System Type: I, II, III, IV, V, VI

System Description: Existing LP Panel Block

Repair System Description: LP Panel Block

Maintenance Agreement Required: ☒ Yes ☐ No

☒ House/Mod. Home ☐ Mobile Home ☐ Business ☐ Other

No. Bedrooms 4 No. Bathrooms 4 No. Employees

☐ Slab ☒ Crawl Space ☐ Basement w/plumbing ☐ Basement wo/plumbing

Water Supply: ☒ Individual ☐ Public ☐ Community


Comments:/Conditions:

1"=50'

Comments:/Conditions: Adding Garage

Existing System Installed 11/12/03

INITIAL SITE SKETCH

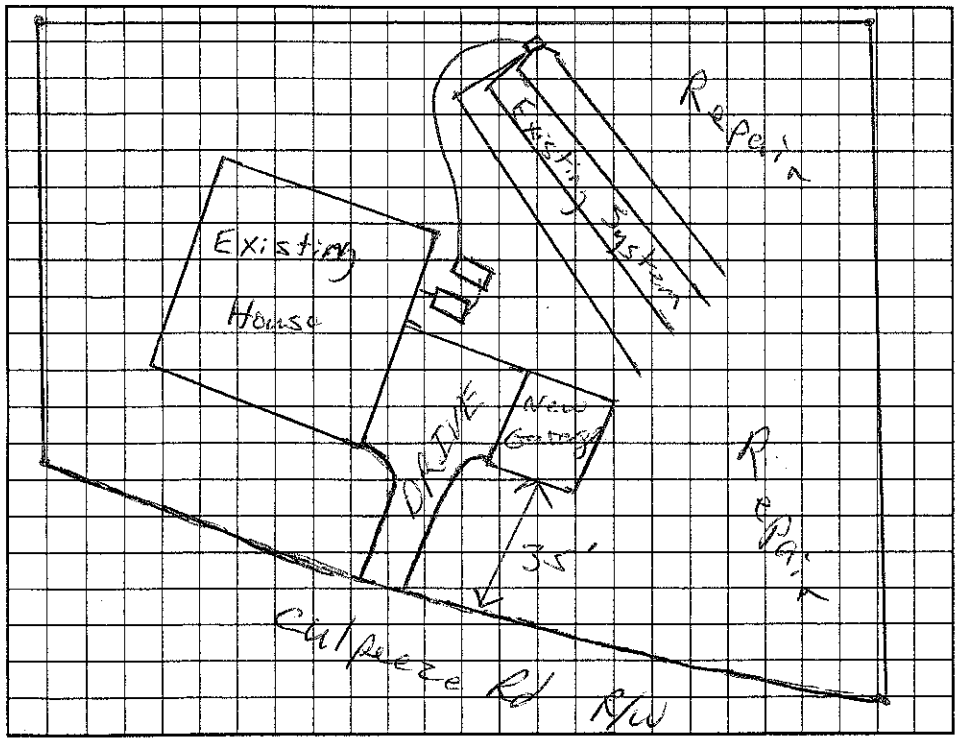


AS BUILT SKETCH

Permit can be suspended or revoked if any false information is supplied toward securing the permit/any unauthorized changes are made to the site/any unauthorized changes are made in the installation of the system. Improvement Permit with plat valid without expiration. Improvement Permit with site plan valid for sixty months. Authorization to Construct is valid for a period equal to that of Improvement Permit – not to exceed sixty months.

Signed: T Carter date 6/9/04 Installed by:

Improvement Permit by: date Operation Permit by: date

Authorization to Construct by: date Existing System Inspection by: date 6/7/04

HEALTH DEPT. COPY: WHITE OWNER COPY (FINAL): YELLOW OWNER COPY (INITIAL): PINK