IREDELL COUNTY HEALTH DEPARTMENT

STATESVILLE 704-878-5305 MOORESVILLE 704-664-5281 11:00

IMPROVEMENT PERMIT / AUTHORIZATION TO CONSTRUCT / OPERATION PERMIT / EXISTING SYSTEM INSPECTION

PERMIT# 111796 PIN# ~~4637-18-2341.9~~ 463712 1802.000 DATE 4/28/03

OWNER OR CONTRACTOR NIBLOCK DEVELOPMENT PHONE: Business 331-4785 Home

ADDRESS 300 MC GILL AVE NW CONCORD NC 28027

LOCATION BRAWLEY SCHOOL - TR BLUME - TL BEATEN PATH - TR CULPEZE STATION RT

SUBDIVISION EDGEWATER PARK BLOCK / SECTION LOT 9 LOT AREA .772 SITE CLASS. PS DESIGN FLOW 460.80 L.T.A.R. .250 PD/FT2

Septic Tank: 1000 Gallons; STB 312 Date 9/12/03

Pump Tank: 1000 Gallons; PT 27 Date 9/11/03

Pump Make: Little Beast Model 9-EH Serial No. 4/1/03

Nitrification Field: No Fields 1 Square Feet 640 Linear Feet 320

No Lines 4 Trench Width 24"-36" Max Trench Bottom Depth 30" 40"

☑ New System ☐ Repair System Type: I, II, III, IV, V, VI

System Description: LP PANEL

Repair System Description: SAME

Maintenance Agreement Required: ☑ Yes ☐ No

Gravel Depth 6" ☐ Slab ☑ Crawl Space ☐ Basement w/plumbing ☐ Basement wo/plumbing

☑ House/Mod. Home No. Bedrooms 4

☐ Mobile Home No. Bathrooms 4

☐ Business No. Employees


☐ Other

Water Supply:
☑ Individual
☐ Public
☐ Community

Comments:/Conditions: DO NOT CUT FOR HOUSE

Comments:/Conditions:

INITIAL SITE SKETCH 1"=50'

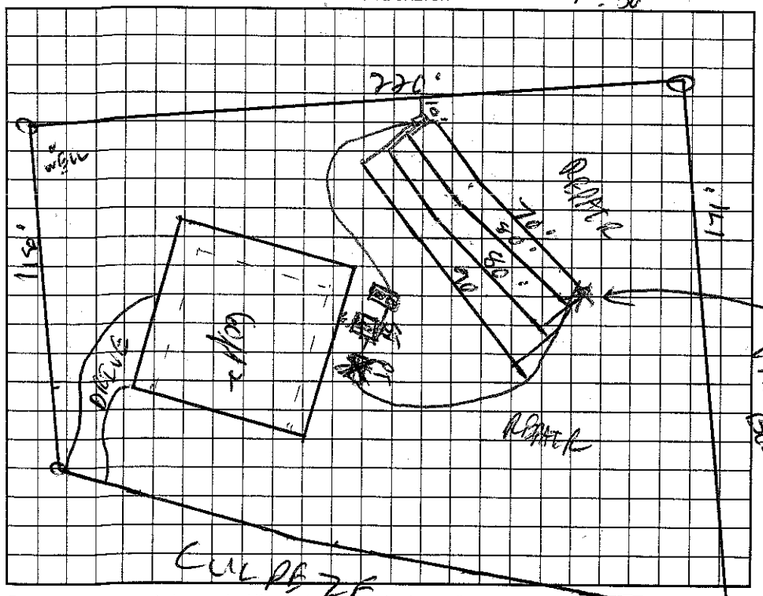

AS BUILT SKETCH

Permit can be suspended or revoked if any false information is supplied toward securing the permit, any unauthorized changes are made to the site/any unauthorized changes are made in the installation of the system. Improvement Permit with plat valid without expiration. Improvement Permit with site plan valid for sixty months. Authorization to Construct is valid for a period equal to that of Improvement Permit – not to exceed sixty months.

Signed: Pat Carpenter date 4/30/03 Installed by: Richard Abernathy

Improvement Permit by: [signature] RS date 4/28/03 Operation Permit by: Wesley Sparks R.S. date 11/12/03

Authorization to Construct by: [signature] RS date 7/31/03 Existing System Inspection by: date

HEALTH DEPT. COPY: WHITE OWNER COPY (FINAL): YELLOW OWNER COPY (INITIAL): PINK