IREDELL COUNTY HEALTH DEPARTMENT

STATESVILLE 704-878-5305 MOORESVILLE 704-664-5281

IMPROVEMENT PERMIT / AUTHORIZATION TO CONSTRUCT / OPERATION PERMIT / EXISTING SYSTEM INSPECTIO

PERMIT# 111769 PIN# 4637122391.5 4637122078 DATE 4/25/03

OWNER OR CONTRACTOR NIBLOCK DEVELOPMENT PHONE: Business 331-4745 Home

ADDRESS 300 McGILL AVE NW CONCORD NC 28027

LOCATION BRAWLEY SCHOOL TR BLUME - TL BEATEN PATH - TR CULPEZE - ON LT

SUBDIVISION EDGEWATER PARK BLOCK / SECTION LOT 5 LOT AREA .836AC SITE CLASS PS DESIGN FLOW 480GPD L.T.A.R. .36 PD/AC

Septic Tank: 1000 Gallons; STB 794 Date 3/27/03
Pump Tank: 1000 Gallons; PT 283 Date 2/11/03
Pump Make: Zoeller Model N-98 Serial No. 7/17/02
Nitrification Field: No Fields 1 Square Feet 1200 Linear Feet 400
No Lines 3@133' Trench Width 36" Max Trench Bottom Depth 36" Gravel Depth N/A

☑ New System ☐ Repair System Type: I, II, (III), IV, V, VI
System Description: PUMP 25% REDUCTION
Repair System Description: SAME
Maintenance Agreement Required: ☐ Yes ☑ No


☑ House/Mod. Home No. Bedrooms 4
☐ Mobile Home No. Bathrooms 4
☐ Business No. Employees
☐ Other
☐ Slab ☑ Crawl Space ☐ Basement w/plumbing ☐ Basement wo/plumbing

Water Supply: ☑ Individual ☐ Public ☐ Community

Comments:/Conditions: 1) DO NOT CUT HOUSE PAD, BUILD UP ONLY. Reviewed site plans & building plans & essentially in compliance with permit. House is slightly larger

Comments:/Conditions: EZ FLOW INSTALLER 5/16/03

INITIAL SITE SKETCH 1"=50'

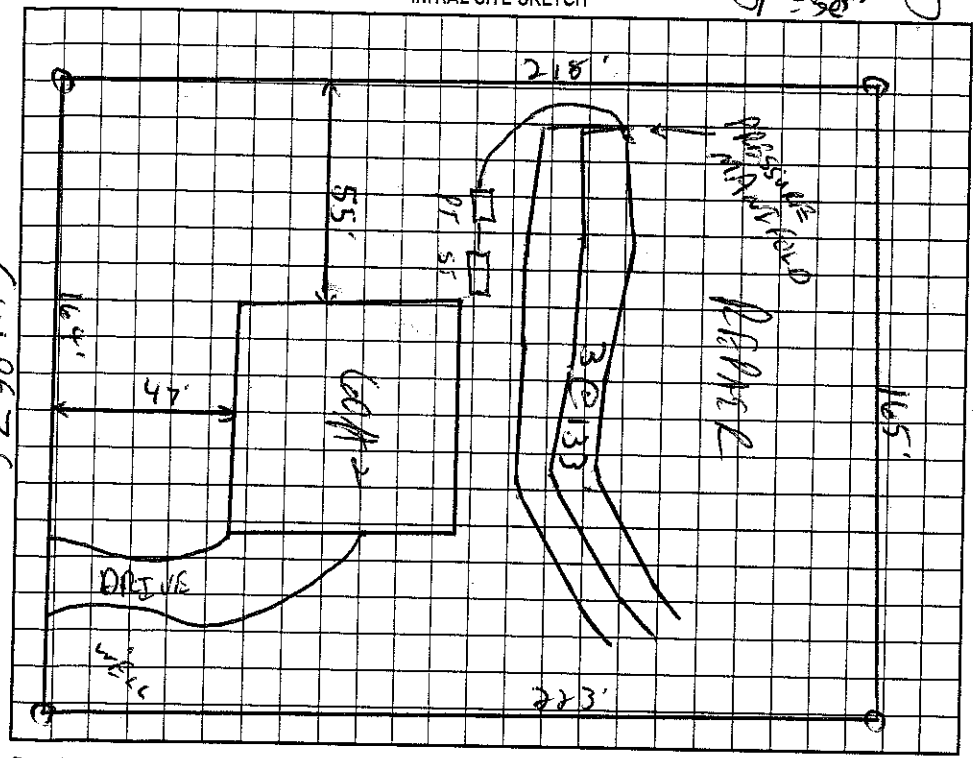

AS BUILT SKETCH

Permit can be suspended or revoked if any false information is supplied toward securing the permit/any unauthorized changes are made to the site/any unauthorized changes are made in the installation of the system. Improvement Permit with plat valid without expiration. Improvement Permit with site plan valid for sixty months. Authorization to Construct is valid for a period equal to that of Improvement Permit – not to exceed sixty months.

Signed: Pat Carpenter date 4/30/03
Improvement Permit by: RS date 4/25/03
Authorization to Construct by: RS date 5/16/03
Installed by: Jerry Walker
Operation Permit by: date 9/3/03
Existing System Inspection by: date

HEALTH DEPT. COPY: WHITE OWNER COPY (FINAL): YELLOW OWNER COPY (INITIAL): PINK