IREDELL COUNTY HEALTH DEPARTMENT

STATESVILLE 704-878-5305 MOORESVILLE 704-664-5281

IMPROVEMENT PERMIT / AUTHORIZATION TO CONSTRUCT / OPERATION PERMIT / EXISTING SYSTEM INSPECTION

PERMIT# 115483 PIN# ~~4637102391.000~~ 4637-12-2696 DATE 10/9/03

OWNER OR CONTRACTOR NIBLOCK DEVELOPMENT PHONE: Business 331-4745 Home

ADDRESS 300 McGILL AVE CONCORD NC 28027

LOCATION RAWLEY SCHOOL - TR BLUME - ON LT

SUBDIVISION EDGEWATER PH. BLOCK / SECTION 2 LOT 12 LOT AREA .74C SITE CLASS. PS DESIGN FLOW 450GPD L.T.A.R. .3640 ~~AC~~

Septic Tank: 1000 Gallons; STB 794 Date 6/27/04

Pump Tank: Gallons; PT Date

Pump Make: Model Serial No.

Nitrification Field: No Fields 1 Square Feet 1230 Linear Feet 410

No Lines 6 Trench Width 36" Max Trench Bottom Depth 36" Gravel Depth N/A

☑ New System ☐ Repair System Type: I, II, III, IV, V, VI

System Description: GRAVITY 25% REDUCTION

Repair System Description: PUMP PANEL

Maintenance Agreement Required: ☐ Yes ☑ No

~~☑~~ House/Mod. Home No. Bedrooms 4

☐ Mobile Home No. Bathrooms 4

☐ Business No. Employees

☐ Other

☐ Slab ☑ Crawl Space ☐ Basement w/plumbing ☐ Basement wo/plumbing

Water Supply: ~~☑~~ Individual ☐ Public ☐ Community


Comments:/Conditions:

DO NOT CUT HOUSE PAD


TOO MUCH GRADING WILL REQUIRE PUMP ADDITION TO SYSTEM.

Comments:/Conditions:

INITIAL SITE SKETCH 1"=50'

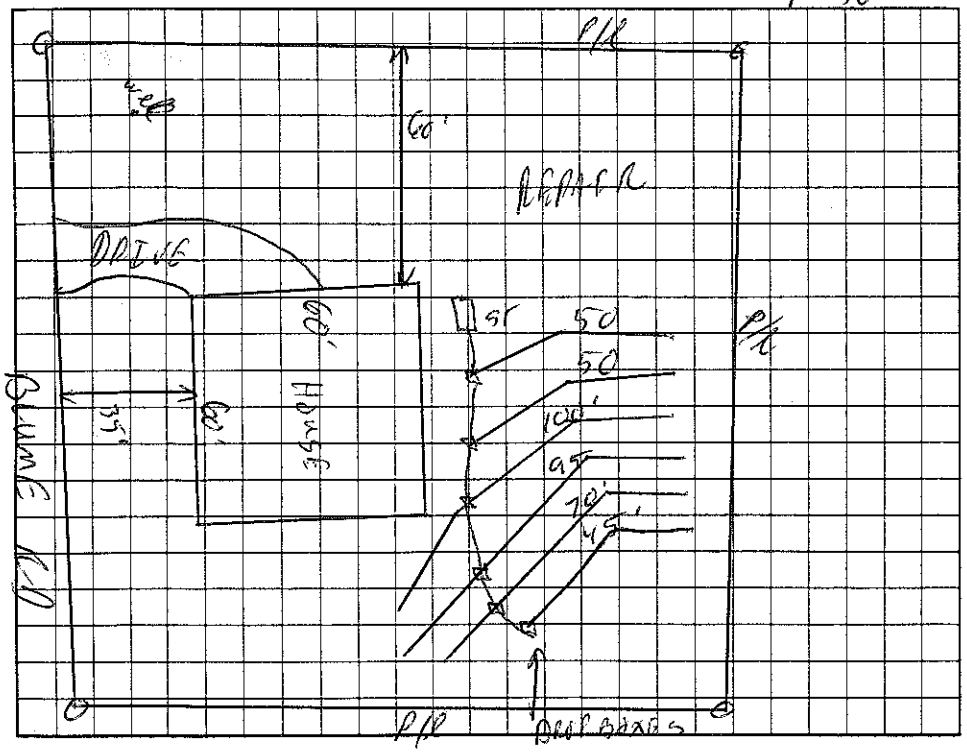

AS BUILT SKETCH

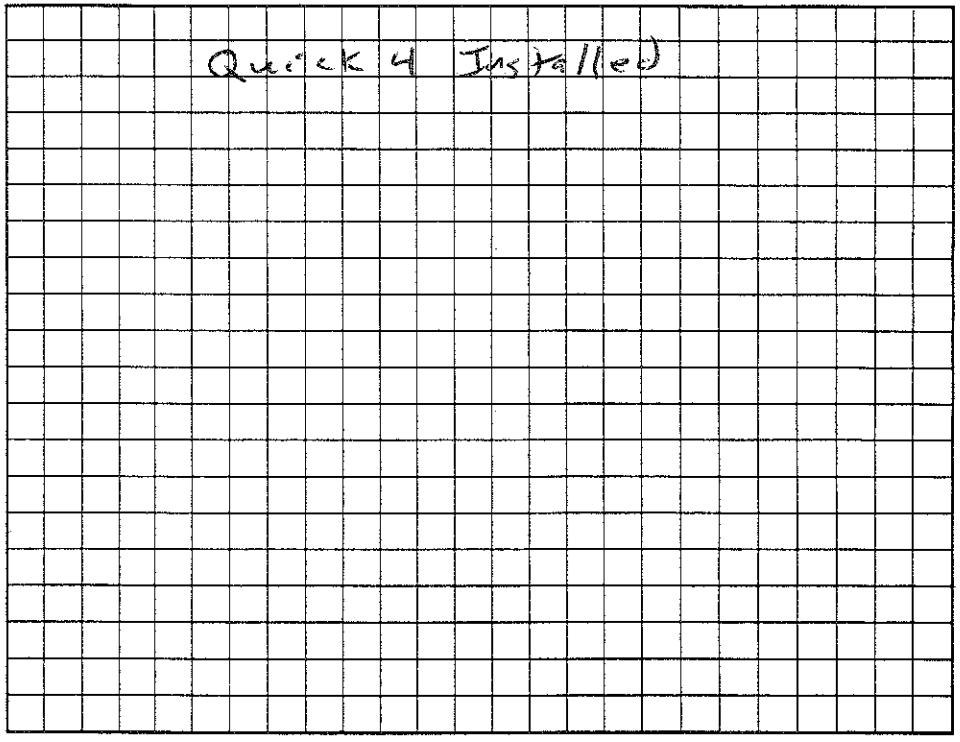

Permit can be suspended or revoked if any false information is supplied toward securing the permit/any unauthorized changes are made to the site/any unauthorized changes are made in the installation of the system. Improvement Permit with plat valid without expiration. Improvement Permit with site plan valid for sixty months. Authorization to Construct is valid for a period equal to that of Improvement Permit -- not to exceed sixty months.

Signed: Pat Carpenter date 10/14/03 Installed by: Abernathy

Improvement Permit by: RS date 10/9/03 Operation Permit by: RS date 8/30/05

Authorization to Construct by: Wesley Sparks RS. date 5/11/05 Existing System Inspection by: date

HEALTH DEPT. COPY: WHITE OWNER COPY (FINAL): YELLOW OWNER COPY (INITIAL): PINK