IREDELL COUNTY HEALTH DEPARTMENT

STATESVILLE 704-878-5305 MOORESVILLE 704-664-5281

IMPROVEMENT PERMIT / AUTHORIZATION TO CONSTRUCT / OPERATION PERMIT / EXISTING SYSTEM INSPECTION

PERMIT# 15482 PIN# ~~4637-12-2391.041~~ ~~47~~ 4637-12-2855 DATE 10/10/03

OWNER OR CONTRACTOR NZBLOCK DEVELOPMENT PHONE: Business 331-4745 Home

ADDRESS 300 McGILL AVENUE · CONCORD

LOCATION BRANCH - TR BUMS - ON LT

SUBDIVISION EDGEWATER PK BLOCK / SECTION 2 LOT 11 LOT AREA .79AC SITE CLASS. #5 DESIGN FLOW 660 L.T.A.R. .30 PP/PD

Septic Tank: 1000 Gallons; STB 794 Date 11-19-04
Pump Tank: Gallons; PT Date
Pump Make: Model Serial No.
Nitrification Field: No Fields 1 Square Feet 1200 Linear Feet 400
No Lines 6 Trench Width 36" Max Trench Bottom Depth 36" Gravel Depth N/A

☑ New System ☐ Repair System Type: I, II, III, IV, V, VI
System Description: GRAVITY 25% REDUCTION
Repair System Description: 1D PANEL
Maintenance Agreement Required: ☐ Yes ☑ No


☑ House/Mod. Home No. Bedrooms 4
☐ Mobile Home No. Bathrooms 4
☐ Business No. Employees
☐ Other
☐ Slab ☑ Crawl Space ☐ Basement w/plumbing ☐ Basement wo/plumbing

Water Supply: ☑ Individual ☐ Public ☐ Community

Comments/Conditions:

Comments/Conditions:

INITIAL SITE SKETCH 1"=50'

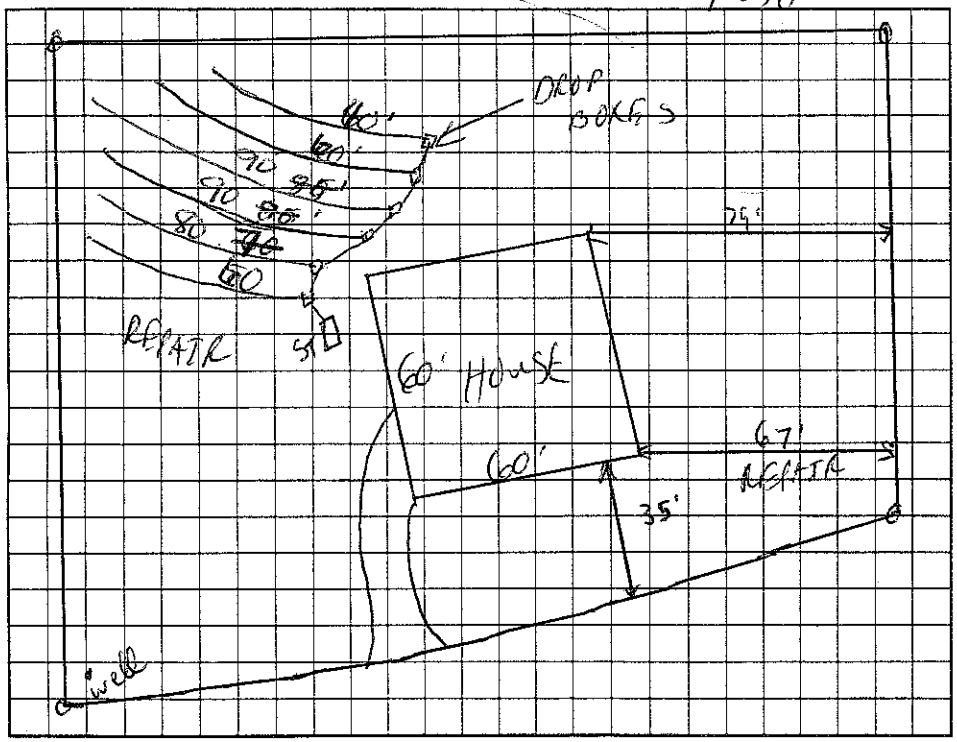

AS BUILT SKETCH

Installed EL Flow in 6 lines (Gets a little deep on end of lines)

Permit can be suspended or revoked if any false information is supplied toward securing the permit/any unauthorized changes are made to the site/any unauthorized changes are made in the installation of the system. Improvement Permit with plat valid without expiration. Improvement Permit with site plan valid for sixty months. Authorization to Construct is valid for a period equal to that of Improvement Permit – not to exceed sixty months.

Signed: Pat Carpenter date 10/14/03 Installed by: Richard Abernathy

Improvement Permit by: [signature] RS date 10/10/03 Operation Permit by: [signature] RS date 12/17/04

Authorization to Construct by: Wesley Sparks R.S. date 8/25/04 Existing System Inspection by: date

HEALTH DEPT. COPY: WHITE OWNER COPY (FINAL): YELLOW OWNER COPY (INITIAL): PINK