IREDELL COUNTY HEALTH DEPARTMENT

STATESVILLE 704-878-5305 MOORESVILLE 704-664-5281

IMPROVEMENT PERMIT / AUTHORIZATION TO CONSTRUCT / OPERATION PERMIT / EXISTING SYSTEM INSPECTIO

PERMIT# 115577 PIN# ~~4637-12-33 91.000~~ 4637-12-3375 DATE 10/9/03

OWNER OR CONTRACTOR NIBLOCK DEVELOPMENT PHONE: Business 331-4745 Home

ADDRESS 300 McGILL AVENUE MOORESVILLE NC 28117

LOCATION BRAWLEY SCHOOL - TR BLUME ON LT

SUBDIVISION EDGEWATER PK BLOCK / SECTION 2 LOT 14 LOT AREA .84AC SITE CLASS. LS DESIGN FLOW 480GPD L.T.A.R. .30 APP/ACC

Septic Tank: 1000 Gallons; STB 794 Date 11/3/04

Pump Tank: Gallons; PT Date

Pump Make: Model Serial No.

Nitrification Field: No Fields 1 Square Feet 1200 Linear Feet 400

No Lines 4@100' Trench Width 36" Max Trench Bottom Depth 36" Gravel Depth N/A

☑ New System ☐ Repair System Type: I, II, (III), IV, V, VI

System Description: GRAVITY 25% REDUCTION

Repair System Description: PUMP STATION

Maintenance Agreement Required: ☐ Yes ☑ No

☑ House/Mod. Home No. Bedrooms 4

☐ Mobile Home No. Bathrooms 4

☐ Business No. Employees

☐ Other


☐ Slab ☑ Crawl Space ☐ Basement w/plumbing ☐ Basement wo/plumbing

Water Supply: ☑ Individual ☐ Public ☐ Community

Comments:/Conditions:

Comments:/Conditions:

INITIAL SITE SKETCH

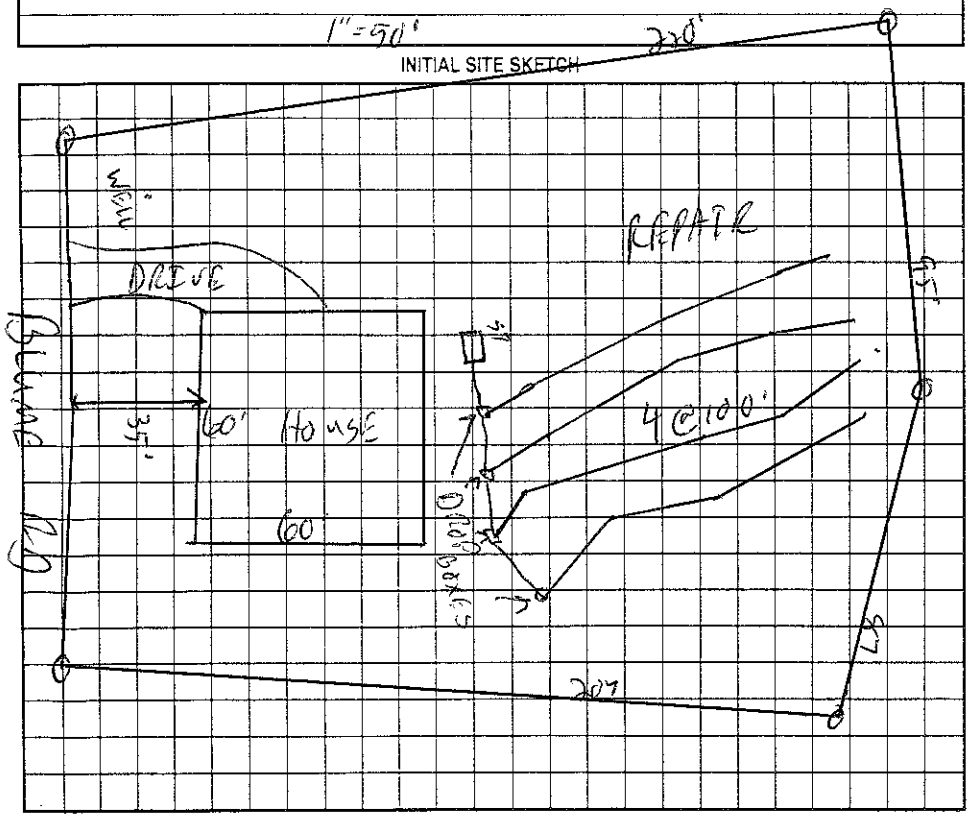

AS BUILT SKETCH

EZ Flow Installed

Permit can be suspended or revoked if any false information is supplied toward securing the permit/any unauthorized changes are made to the site/any unauthorized changes are made in the installation of the system. Improvement Permit with plat valid without expiration. Improvement Permit with site plan valid for sixty months. Authorization to Construct is valid for a period equal to that of Improvement Permit -- not to exceed sixty months.

Signed: Pat Clayton date 10/14/03

Improvement Permit by: RS date 10/9/03

Authorization to Construct by: RS date 9/2/04

Installed by: Abernathy

Operation Permit by: RS date 12/22/04

Existing System Inspection by: date

HEALTH DEPT. COPY: WHITE OWNER COPY (FINAL): YELLOW OWNER COPY (INITIAL): PINK