IREDELL COUNTY HEALTH DEPARTMENT

STATESVILLE 704-878-5305 MOORESVILLE 704-664-5281

IMPROVEMENT PERMIT / AUTHORIZATION TO CONSTRUCT / OPERATION PERMIT / EXISTING SYSTEM INSPECTION

PERMIT# 115639 PIN# ~~4637-10-3391.015~~ 4637-12-4251 DATE 10/7/03

OWNER OR CONTRACTOR NIBLOCK DEVELOPMENT PHONE: Business 788-4818 Home

ADDRESS 300 McGILL AVENUE NW

LOCATION BRANLEY SCHOOL - TR BLUME RD - ON LT

SUBDIVISION EDGEWATER PARK BLOCK / SECTION 2 LOT 15 LOT AREA 1.61AC SITE CLASS. RS DESIGN FLOW 480GPD L.T.A.R. 1.36/1.72

Septic Tank: 1000 Gallons; STB 312 Date 3/19/04
Pump Tank: Gallons; PT Date
Pump Make: Model Serial No.
Nitrification Field: No Fields 1 Square Feet 1200 Linear Feet 400
No Lines 4@100' Trench Width 36" Max Trench Bottom Depth 36" Gravel Depth N/A

☑ New System ☐ Repair System Type: I, II, (III), IV, V, VI
System Description: GRAVITY 25% REDUCTION
Repair System Description: PUMP SAME
Maintenance Agreement Required: ☐ Yes ☑ No


☑ House/Mod. Home No. Bedrooms 4
☐ Mobile Home No. Bathrooms 4
☐ Business No. Employees
☐ Other
☐ Slab ☑ Crawl Space ☐ Basement w/plumbing ☐ Basement wo/plumbing

Water Supply: ☑ Individual ☐ Public ☐ Community

Comments:/Conditions: Reviewed Building plans & site plans; essentially in Compliance with orginal permit.

Comments:/Conditions: 5/27/04 Lines installed as shown. EZ FLOW INSTALLED

INITIAL SITE SKETCH 1"=50'

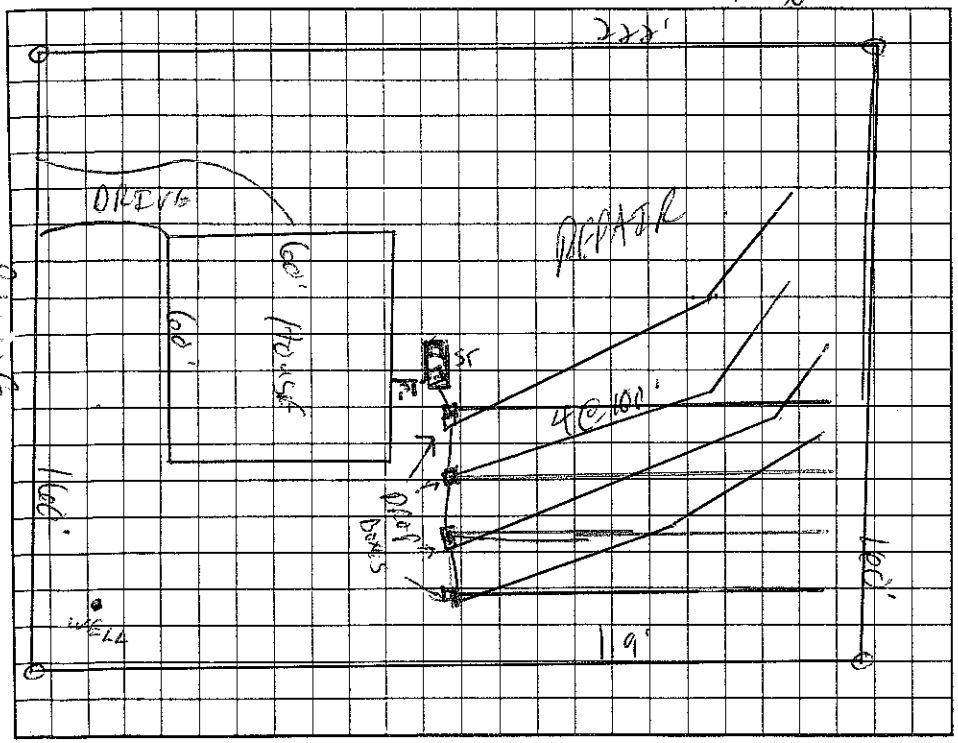

AS BUILT SKETCH

Permit can be suspended or revoked if any false information is supplied toward securing the permit/any unauthorized changes are made to the site/any unauthorized changes are made in the installation of the system. Improvement Permit with plat valid without expiration. Improvement Permit with site plan valid for sixty months. Authorization to Construct is valid for a period equal to that of Improvement Permit – not to exceed sixty months.

Signed: Pat Carpenter date 10/14/03 Installed by: Richard Abernathy

Improvement Permit by: RS date 10/7/03 Operation Permit by: Wesley Parks RS. date 5/27/04

Authorization to Construct by: RS date 3/29/04 Existing System Inspection by: date

HEALTH DEPT. COPY: WHITE OWNER COPY (FINAL): YELLOW OWNER COPY (INITIAL): PINK