1130

IREDELL COUNTY HEALTH DEPARTMENT

STATESVILLE 704-878-5305 MOORESVILLE 704-664-5281

IMPROVEMENT PERMIT / AUTHORIZATION TO CONSTRUCT / OPERATION PERMIT / EXISTING SYSTEM INSPECTION

PERMIT# 100350 PIN# ~~4639-24-4601 (pt)~~ 4639-12-5656 DATE June 26, 01

OWNER OR CONTRACTOR Blume Road Partners / K W Korte PHONE: Business Home

ADDRESS 149 Great Cove Rd. Mooresville N.C. 28117

LOCATION Brawley School Rd TR Blume Rd. on Right

SUBDIVISION Devonshire BLOCK / SECTION LOT 17 LOT AREA .79AC SITE CLASS. PS DESIGN FLOW 480 gpd L.T.A.R. ~.25

Septic Tank: 1000 Gallons; STB 1012 Date 6-17-02

Pump Tank: Gallons; PT Date

Pump Make: Model Serial No.

Nitrification Field: No Fields 1 Square Feet 1440 Linear Feet 480

No Lines 6 Trench Width 36" Max Trench Bottom Depth 36"

☑ New System ☐ Repair System Type: I, II, III, IV, V, VI

System Description: Gravity Innovative -25% Red. LPP PBTS

Repair System Description:

Maintenance Agreement Required: ☐ Yes ☑ No initially

Gravel Depth NA

☑ House/Mod. Home No. Bedrooms 4

☐ Mobile Home No. Bathrooms 4

☐ Business No. Employees

☐ Other


☐ Slab ☑ Crawl Space ☐ Basement w/plumbing ☐ Basement wo/plumbing

Water Supply: ☑ Individual ☐ Public ☐ Community

Comments:/Conditions:

Comments:/Conditions: Yellow filter installed

INITIAL SITE SKETCH 1" = 50'

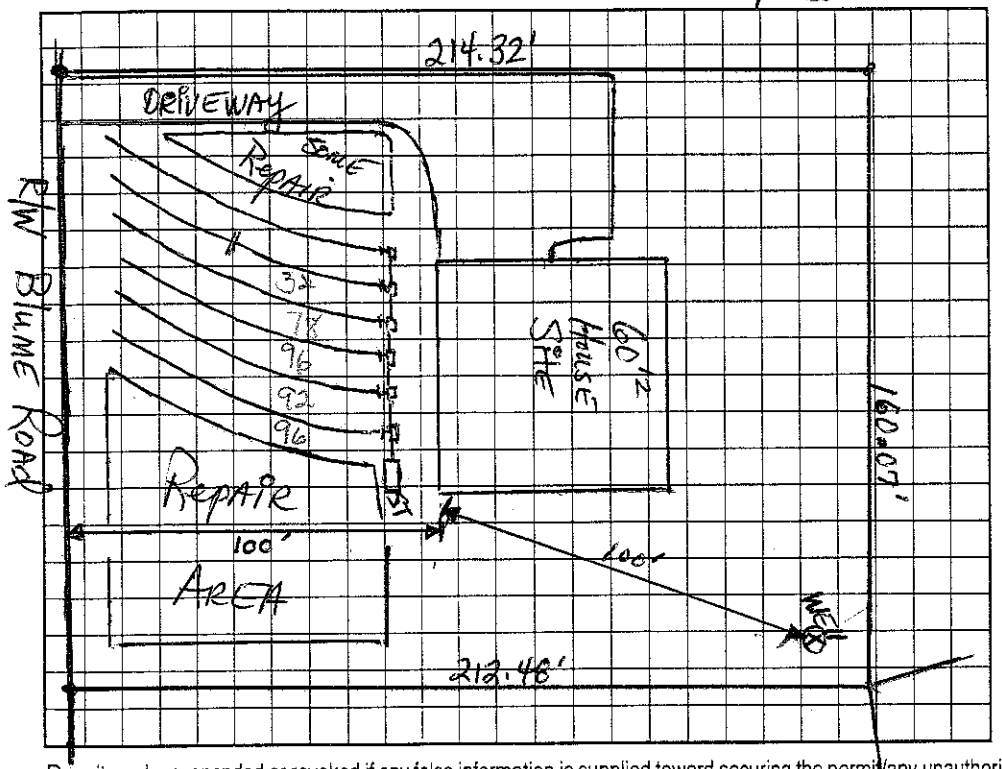

AS BUILT SKETCH

Installed "Plastic Chamber" in 5 varing length lines.

Permit can be suspended or revoked if any false information is supplied toward securing the permit/any unauthorized changes are made to the site/any unauthorized changes are made in the installation of the system. Improvement Permit with plat valid without expiration. Improvement Permit with site plan valid for sixty months. Authorization to Construct is valid for a period equal to that of Improvement Permit – not to exceed sixty months.

Signed: date 7.17.01 Installed by: Tommy Frye Grading

Improvement Permit by: date 6-26-01 Operation Permit by: date 12/19/02

Authorization to Construct by: date 6/17/02 Existing System Inspection by: date

HEALTH DEPT. COPY: WHITE OWNER COPY (FINAL): YELLOW OWNER COPY (INITIAL): PINK