# IREDELL COUNTY HEALTH DEPARTMENT

STATESVILLE 704-878-5305 MOORESVILLE 704-664-5281

## IMPROVEMENT PERMIT / AUTHORIZATION TO CONSTRUCT / OPERATION PERMIT / EXISTING SYSTEM INSPECTION

50.00 Paid

PERMIT# ~~100351~~ 100351 PIN# ~~4637-21-4661-PT~~ 4637-12-5813 DATE 7/15/02

OWNER OR CONTRACTOR JS REGAL LLC PHONE: Business 704-509-9100 Home

ADDRESS 11145 MCTEMAN · CHARLOTTE NC 28269 374 BLUME RD.

LOCATION BRAWLEY SCHOOL - TR BLUME ON RT

SUBDIVISION DEVONSHIRE BLOCK / SECTION LOT 18 LOT AREA .83AC SITE CLASS. PS DESIGN FLOW 360GPD L.T.A.R. .25 gpd/sf

Septic Tank: 1000 Gallons; STB 794 Date 9/21/02
Pump Tank: Gallons; PT Date
Pump Make: Model Serial No.
Nitrification Field: No Fields 1 Square Feet 1050 Linear Feet 360
No Lines SGT Trench Width 36" Max Trench Bottom Depth 36" Gravel Depth N/A

☑ New System ☐ Repair System Type: I, II, III, IV, V, VI
System Description: GRAVITY INNOVATIVE
Repair System Description: SAME
Maintenance Agreement Required: ☐ Yes ☑ No


☑ House/Mod. Home No. Bedrooms 3
☐ Mobile Home No. Bathrooms 3
☐ Business No. Employees
☐ Other
☐ Slab ☑ Crawl Space ☐ Basement w/plumbing ☐ Basement wo/plumbing

Water Supply: ☑ Individual ☐ Public ☐ Community

Comments/Conditions: 1) REVIEWED HOUSE PLAN - 7/12/02

Comments/Conditions: EZFLOW INSTALLED

INITIAL SITE SKETCH 1" = 50'

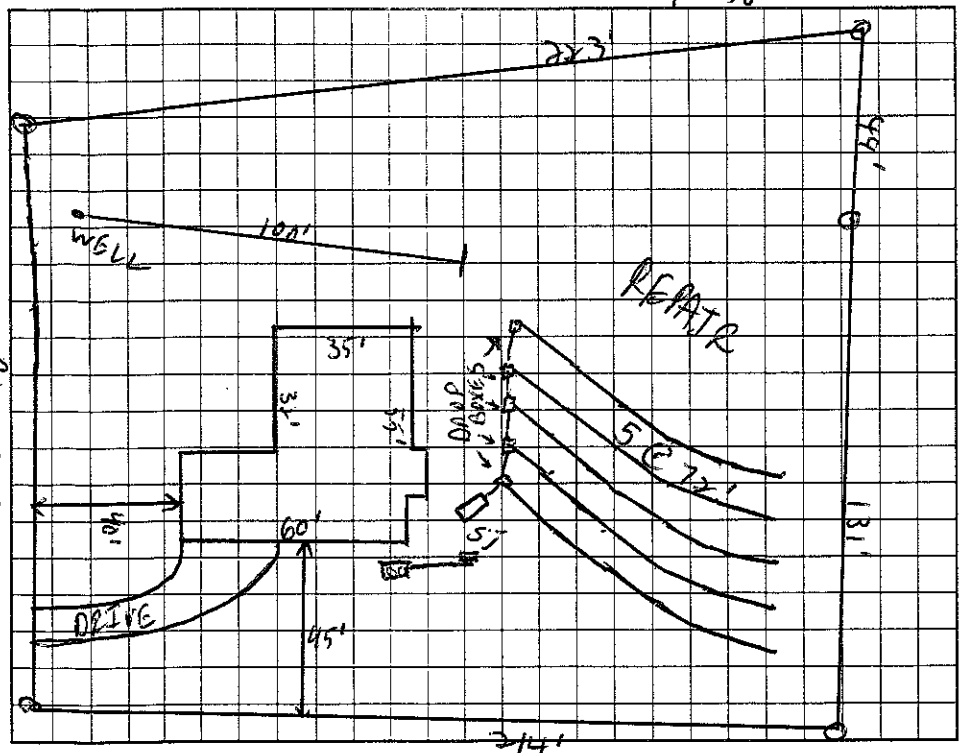


AS BUILT SKETCH

Permit can be suspended or revoked if any false information is supplied toward securing the permit/any unauthorized changes are made to the site/any unauthorized changes are made in the installation of the system. Improvement Permit with plat valid without expiration. Improvement Permit with site plan valid for sixty months. Authorization to Construct is valid for a period equal to that of Improvement Permit – not to exceed sixty months.

Signed: Michael J. Testa member/manager date 7/16/02 Installed by: Carlson Const.

Improvement Permit by: [signature] RS date 7/15/02 Operation Permit by: Wesley Sparks RS date 12/18/02

Authorization to Construct by: [signature] RS date 7/15/02 Existing System Inspection by: date

HEALTH DEPT. COPY: WHITE OWNER COPY (FINAL): YELLOW OWNER COPY (INITIAL): PINK