IREDELL COUNTY HEALTH DEPARTMENT

STATESVILLE 704-878-5305 MOORESVILLE 704-664-5281

IMPROVEMENT PERMIT / AUTHORIZATION TO CONSTRUCT / OPERATION PERMIT / EXISTING SYSTEM INSPECTION

PERMIT# 11564.5 PIN# ~~4637123391.017~~ 4637-12-6942 DATE 10/7/03

OWNER OR CONTRACTOR NIBLOCK DEVELOPMENT PHONE: Business 331-7745 Home

ADDRESS 300 McGILL AVE NW CONCORD NC 28027

LOCATION BRANCH SCHOOL - TR BLUME - ON LT

SUBDIVISION EDGEWATER PK BLOCK / SECTION 2 LOT 17 LOT AREA 1.99AC SITE CLASS LS DESIGN FLOW 450GPD L.T.A.R. .36 / 1.2

Septic Tank: 1000 Gallons; STB 794 Date 4-18-04

Pump Tank: Gallons; PT Date

Pump Make: Model Serial No.

Nitrification Field: No Fields 1 Square Feet 1000 Linear Feet 400

No Lines 4 @ 100' Trench Width 36" Max Trench Bottom Depth 36" Gravel Depth N/A

☑ New System ☐ Repair System Type: I, II, III, IV, V, VI

System Description: GRAVITY 25% REDUCTION

Repair System Description: LP 25% REDUCTION

Maintenance Agreement Required: ☐ Yes ☑ No

☑ House/Mod. Home No. Bedrooms 4

☐ Mobile Home No. Bathrooms 4

☐ Business No. Employees

☐ Other


☐ Slab ☑ Crawl Space ☐ Basement w/plumbing ☐ Basement wo/plumbing

Water Supply: ☑ Individual ☐ Public ☐ Community

Comments:/Conditions:

1" = 50'

INITIAL SITE SKETCH

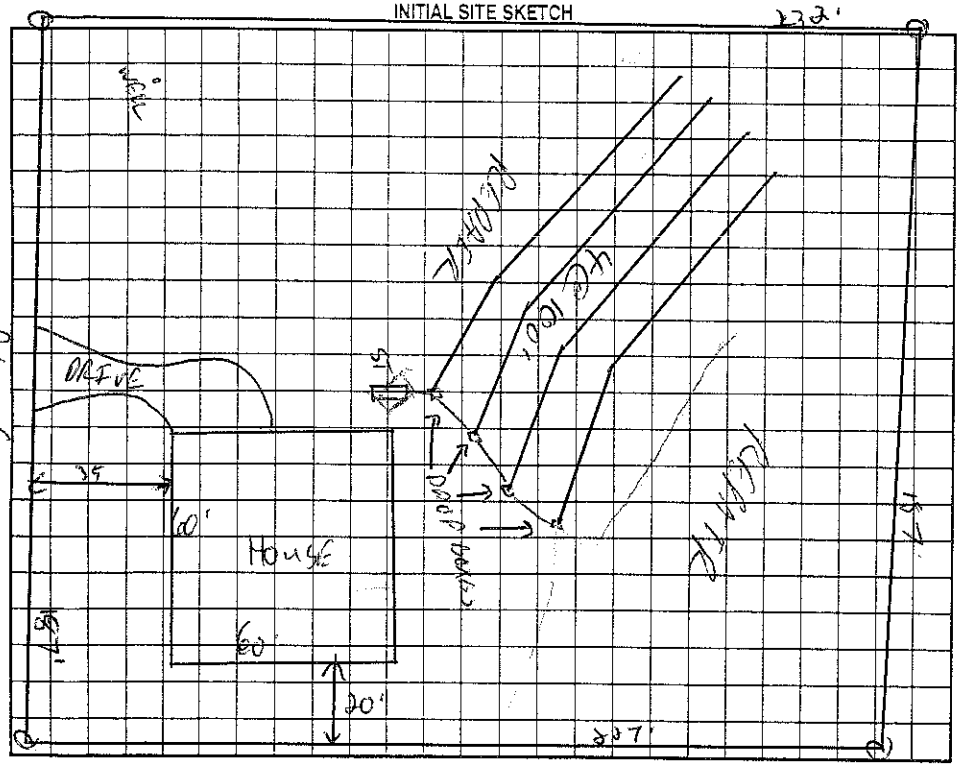

Comments:/Conditions:

AS BUILT SKETCH

Used "plastic chambers" For Drainfield Installed as Drawn

Permit can be suspended or revoked if any false information is supplied toward securing the permit/any unauthorized changes are made to the site/any unauthorized changes are made in the installation of the system. Improvement Permit with plat valid without expiration. Improvement Permit with site plan valid for sixty months. Authorization to Construct is valid for a period equal to that of Improvement Permit – not to exceed sixty months.

Signed: Pat Carpenter date 10/14/03

Improvement Permit by: R.S. date 10/7/03

Authorization to Construct by: R.S. date 2/26/04

Installed by: Richard Abernathy

Operation Permit by: Mark H. Dotson B.S. date 5/26/04

Existing System Inspection by: date

HEALTH DEPT. COPY: WHITE OWNER COPY (FINAL): YELLOW OWNER COPY (INITIAL): PINK