1:30 Expansion

IREDELL COUNTY HEALTH DEPARTMENT

STATESVILLE 704-878-5305 MOORESVILLE 704-664-5281

IMPROVEMENT PERMIT / AUTHORIZATION TO CONSTRUCT / OPERATION PERMIT / EXISTING SYSTEM INSPECTION

PERMIT# 147597 PIN# 4637126942 DATE 1-22-08

OWNER OR APPLICANT William & Angela Boggess PHONE: Business 704 758-4209 Home 704 322-4971

ADDRESS 335 Blume Rd Mooresville, NC 28117

LOCATION Brawley School Rd TR Blume Rd on left just after Beaten Path #335

SUBDIVISION Edgewater Pk BLOCK / SECTION 2 LOT 11 LOT AREA .99 Acre SITE CLASS. PS DESIGN FLOW 600gpd L.T.A.R. .3

Septic Tank: X 1500 Gallons; STB 794 Date 1-1-08 — ☐ New System ☐ Repair ☒ Expansion System Type: I II III IV V VI — ☒ House/Mod. Home ☐ Mobile Home ☐ Business ☐ Other — No. Bedrooms 5 No. Persons ___ No. Employees ___ — Water Supply: X Individual ☐ Public ☐ Community

Pump Tank: 1000 Gallons; PT ___ Date ___ — System Description: Gravity - 25% Reduction

Pump Make: ___ Model ___ Serial No. ___ — Repair System Description: Pump & P-Panel Blk

Nitrification Field: No Fields 1 Square Feet 300' Linear Feet 100' — Maintenance Agreement Required: ☐ Yes ☒ No


No Lines 2 @ 50' Trench Width 36" Max Trench Bottom Depth 36" Gravel Depth N/A ☐ Gravity ☒ Pressure ☒ Slab ☒ Crawl Space ☐ Basement w/plumbing ☐ Basement wo/plumbing

Add to Existing Field

Comments:/Conditions: X Note; either add new 1500 gal & remove/abandon old ST or add new 1000 gal & use in conjunction with existing ST

Comments:/Conditions: Upgrading from 4 Bedrooms to 5 Bedrooms Add 2-50Ft lines & replace ST with 1500g or add a second ST to equal 1500gal or more

PL 233.2.5 INITIAL SITE SKETCH Scale 1:50

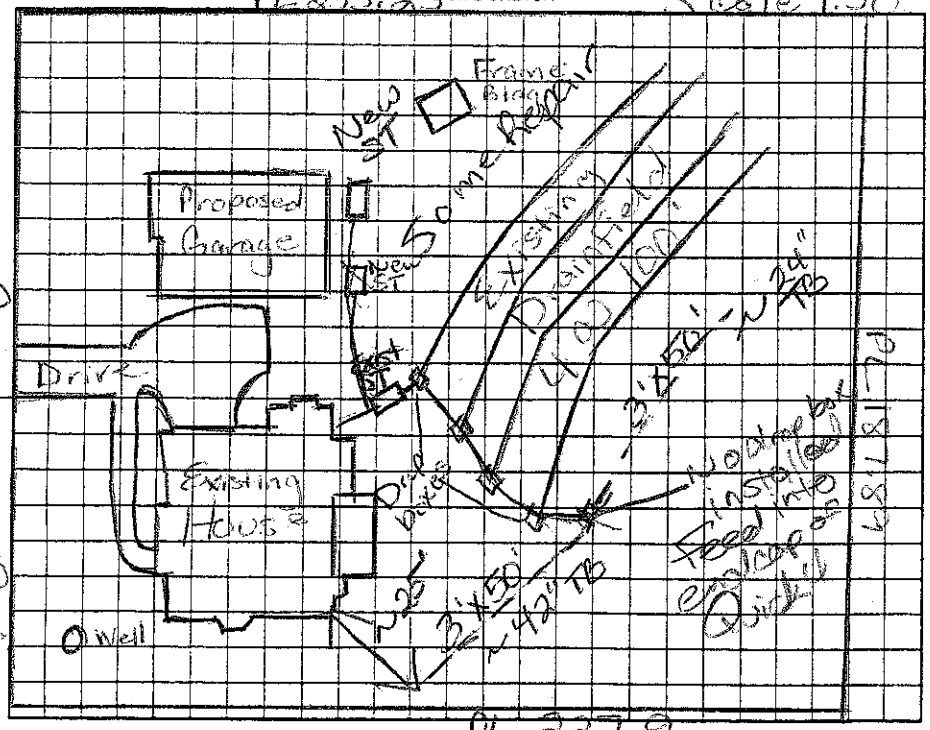

PL 227.9

AS BUILT SKETCH

3/19/08 Installed 2-50' lines Quicky Installed new 1000g ST & will feed through existing ST to Drainfield

Permit can be suspended or revoked if any false information is supplied toward securing the permit/any unauthorized changes are made to the site/any unauthorized changes are made in the installation of the system. Improvement Permit with plat valid without expiration ☐ Improvement Permit with site plan valid for sixty months ☐ Authorization to Construct is valid for a period equal to that of Improvement Permit - not to exceed sixty months.

Signed: [signature] date 1/30/08 Installed by: Richard Abernathy

Improvement Permit by: Maina M. Dotson RS date 1/22/08 Operation Permit by: Maina M. Dotson RS date 3/19/08

Authorization to Construct by: Maina M. Dotson RS date 1/22/08 Existing System Inspection by: ___ date ___

HEALTH DEPT. COPY: WHITE OWNER COPY (FINAL): YELLOW OWNER COPY (INITIAL): PINK