2100

IREDELL COUNTY HEALTH DEPARTMENT

STATESVILLE 704-878-5305 MOORESVILLE 704-664-5281

IMPROVEMENT PERMIT / AUTHORIZATION TO CONSTRUCT / OPERATION PERMIT / EXISTING SYSTEM INSPECTION

PERMIT# 150236 PIN# 4637127273 DATE 5-[illegible]-08

OWNER OR APPLICANT Miller-McCormick Investments PHONE: Business 704-682-6340 Home

ADDRESS 270 Sandhills Court Mooresville NC 28115

LOCATION Brawley School Rd, TR Blume, on R

SUBDIVISION Devonshire BLOCK / SECTION LOT 14 LOT AREA .91 AC SITE CLASS. PS DESIGN FLOW 480 L.T.A.R. .3

Septic Tank: 1000 Gallons: STB 794 Date 6-2-12
Pump Tank: Gallons: PT Date
Pump Make: Model Serial No.
Nitrification Field: No Fields 1 Square Feet 1200' Linear Feet 400'
No Lines 4@100' Trench Width 36" Max Trench Bottom Depth 36" Gravel Depth —

☒ New System ☐ Repair ☐ Expansion System Type: I II (III) IV V VI
System Description: Gravity 25%
Repair System Description: LP PPBPS
Maintenance Agreement Required: ☐ Yes ☒ No Initially
☒ Gravity ☐ Pressure

☒ House/Mod. Home No. Bedrooms 4
☐ Mobile Home No. Persons
☐ Business No. Employees
☐ Other


Water Supply: ☒ Individual ☐ Public ☐ Community

☐ Slab ☒ Crawl Space ☐ Basement w/plumbing ☐ Basement wo/plumbing

Comments:/Conditions:

Comments:/Conditions: 36' btw House & PL ST
19' off PL & 12' to Hse
ADD 36 (5-FT) Plastic Chambers

INITIAL SITE SKETCH

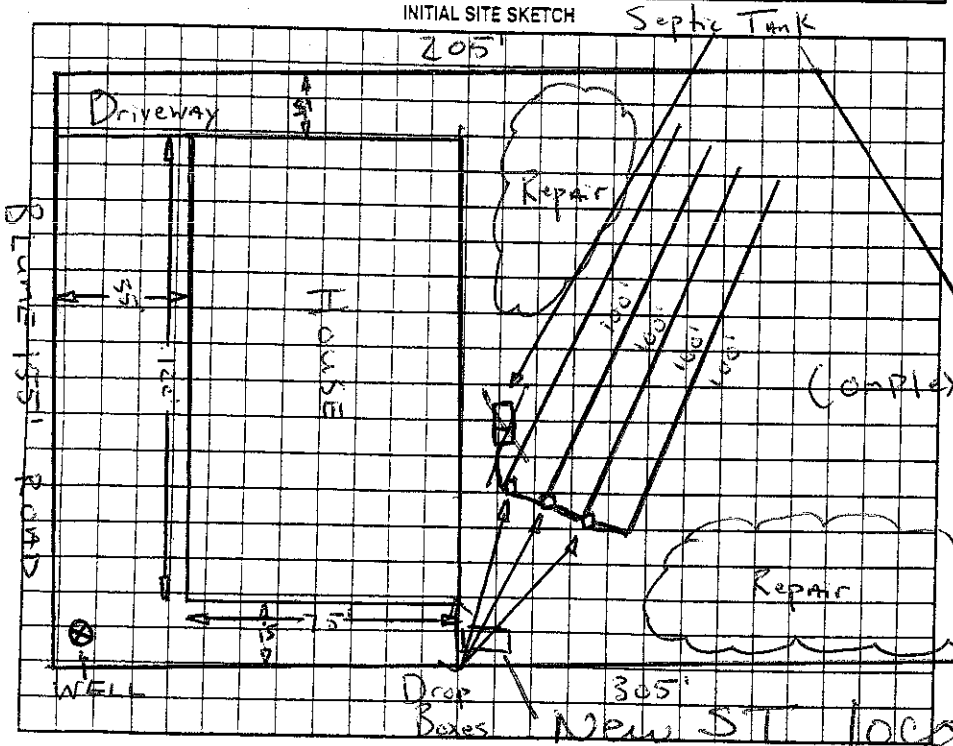

AS BUILT SKETCH

Installed essentially as Drawn except ST to side of House

Permit can be suspended or revoked if any false information is supplied toward securing the permit/any unauthorized changes are made to the site/any unauthorized changes are made in the installation of the system. Improvement Permit with plat valid without expiration ☐ Improvement Permit with site plan valid for sixty months ☒ Authorization to Construct is valid for a period equal to that of Improvement Permit – not to exceed sixty months.

Signed: date 6/13/08

Improvement Permit by: date 5-27-08

Authorization to Construct by: date 3-15-12

Installed by:

Operation Permit by: date 7/19/12

Existing System Inspection by: date

HEALTH DEPT. COPY: WHITE OWNER COPY (FINAL): YELLOW OWNER COPY (INITIAL): PINK