# IREDELL COUNTY HEALTH DEPARTMENT

STATESVILLE 704-878-5305 MOORESVILLE 704-664-5281

## IMPROVEMENT PERMIT / AUTHORIZATION TO CONSTRUCT / OPERATION PERMIT / EXISTING SYSTEM INSPECTION

PERMIT# 100276 PIN# 4637721460 (pt) 4637-12-8068 DATE June 25, 01

OWNER OR CONTRACTOR Blume Road Partners / Wilson Vohs PHONE: Business Home

ADDRESS 149 Yacht Cove Mooresville NC 28117 334 Blume Rd

LOCATION Brawley Sch RD. TR Blume Road on Right

SUBDIVISION Devonshire BLOCK / SECTION LOT 12 LOT AREA .74 Ac SITE CLASS. PS DESIGN FLOW 480gpd L.T.A.R. .3

Septic Tank: 1000 Gallons; STB 794 Date 3/4/02

Pump Tank: Gallons; PT Date

Pump Make: Model Serial No.

Nitrification Field: No Fields 1 Square Feet 500/750 Linear Feet 250

No Lines 5 Trench Width 24" min 6'oc Max Trench Bottom Depth 36" Gravel Depth NA

☑ New System ☐ Repair System Type: I, II, III, IV, V, VI

System Description: Gravity PPBPS

Repair System Description: LPP PPBPS

Maintenance Agreement Required: ☐ Yes ☑ No initially

☑ House/Mod. Home ☐ Mobile Home ☐ Business ☐ Other

No. Bedrooms 4 No. Bathrooms 4 No. Employees

☐ Slab ☑ Crawl Space ☐ Basement w/plumbing ☐ Basement wo/plumbing


Water Supply: ☑ Individual ☐ Public ☐ Community

Comments:/Conditions: OR3649'oc

Reviewed Building plans & Site Plan and it's in compliance with Septic permit. 6/27/02 MD

Comments:/Conditions: PPBPS INSTALLED.

INITIAL SITE SKETCH

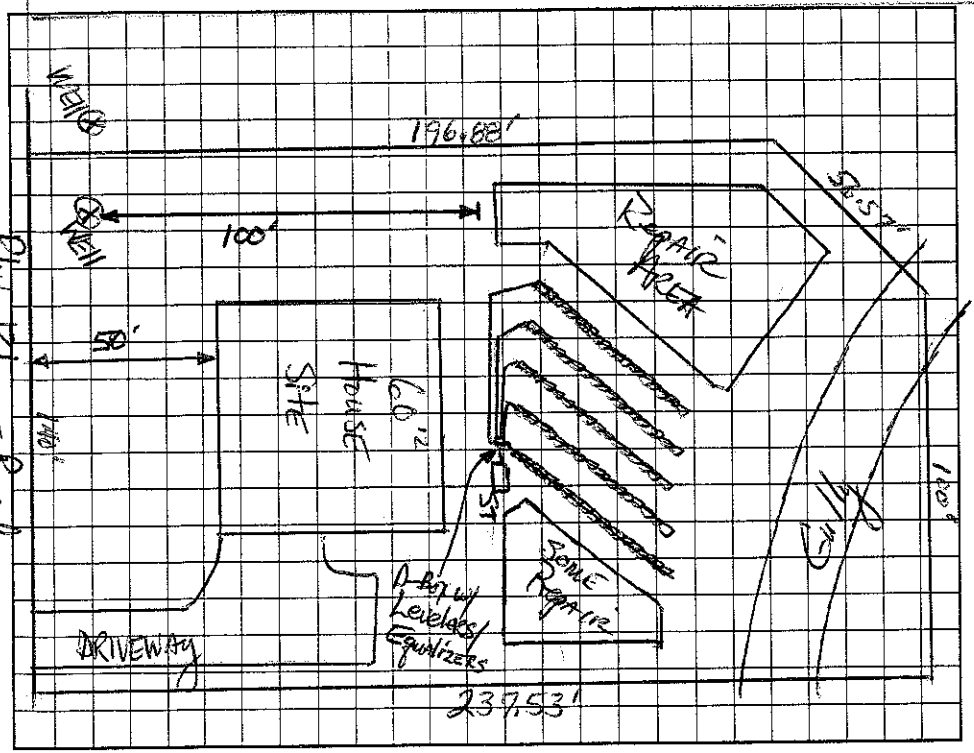


AS BUILT SKETCH

Permit can be suspended or revoked if any false information is supplied toward securing the permit/any unauthorized changes are made to the site/any unauthorized changes are made in the installation of the system. Improvement Permit with plat valid without expiration. Improvement Permit with site plan valid for sixty months. Authorization to Construct is valid for a period equal to that of Improvement Permit – not to exceed sixty months.

Signed: date 7.17.01

Improvement Permit by: date 6-25-01

Authorization to Construct by: date 6/27/01

Installed by: Larry Beam

Operation Permit by: Wesley Sparks R.S. date 12/19/02

Existing System Inspection by: date

HEALTH DEPT. COPY: WHITE OWNER COPY (FINAL): YELLOW OWNER COPY (INITIAL): PINK