IREDELL COUNTY HEALTH DEPARTMENT

Statesville Office (704) 878-5305 Mooresville Office (704) 660-3625 PERMIT # 141696

IMPROVEMENT PERMIT / AUTHORIZATION TO CONSTRUCT / OPERATION PERMIT / EXISTING SYSTEM

PIN # 4637-12-8515

APPLICANT: IQ Custom Construction Inc APPLICANT ADDRESS: 840 Edmiston Rd Mt Ulla NC 28125

SITE ADDRESS: 166 Patternote Rd PHONE: 704-400-6472 ALT. PHONE:

SITE DIRECTIONS: Brawley Schl Rd, TR on Blume, TR on Patternote, Lot on Right


SUBDIVISION: Devonshire SECTION: LOT # 26 LOT AREA: 1.31 ac DESIGN FLOW: 480 gpd L.T.A.R.: 0.3

Septic Tank	1000	(gal)	STB	INFILTRATOR	Date	1/11/2000	☑ New System	☐ Repair	☐ Expansion	System Type: I II III IV V VI	
Pump Tank		(gal)	PT		Date		System Description:	Gravity 25% Reduction			
Pump Make			Model		Serial #		Repair System Description:	LP PPBPS			
# Nitrification Fields	1		# Lines	4	Linear Ft:	400	Maintenance Agreement Required:	☐ YES	☑ NO		
Trench Width	36"		Max. Trench Bottom Depth	36"	Gravel Depth	N/A	☑ GRAVITY	☐ PRESSURE			


☑ Residence	No. Bedrooms	4	Water Supply
☐ Business	No. Persons	8	☑ Private
☐ Other	No. Employees		☐ Public
☑ Slab	☐ Crawl Space		☐ Community
☐ Basement w/plumbing		☐ Basement w/o plumbing	

Comments / Conditions:

INITIAL SITE SKETCH

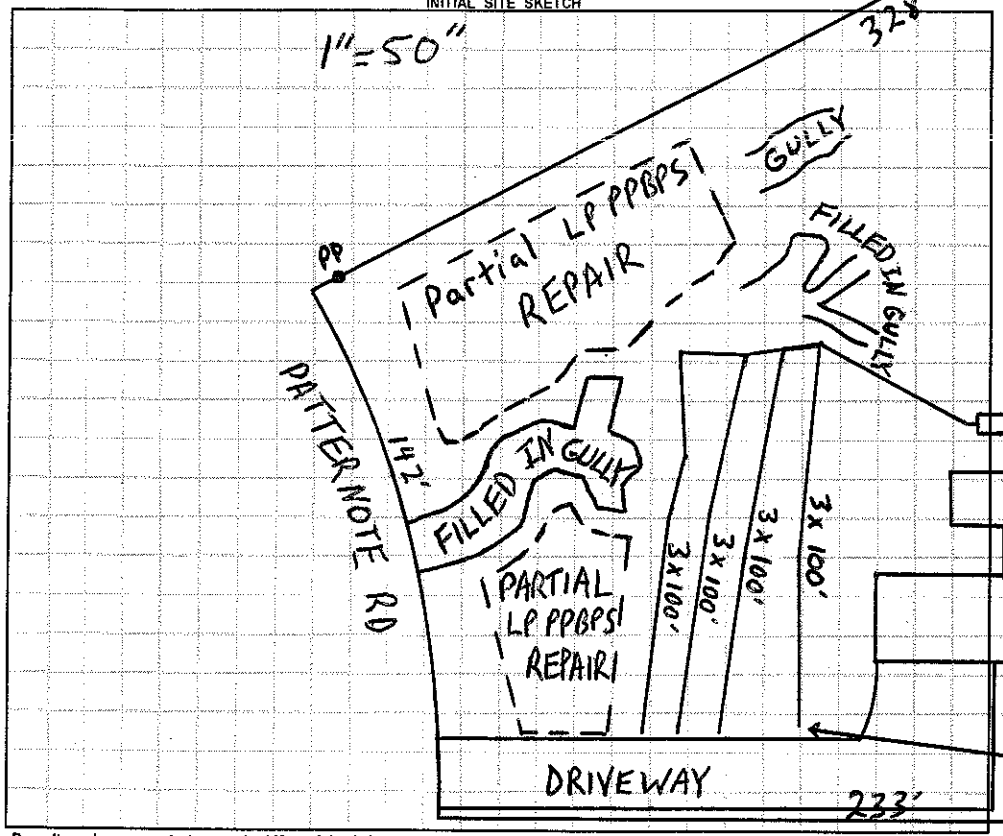

AS BUILT SKETCH

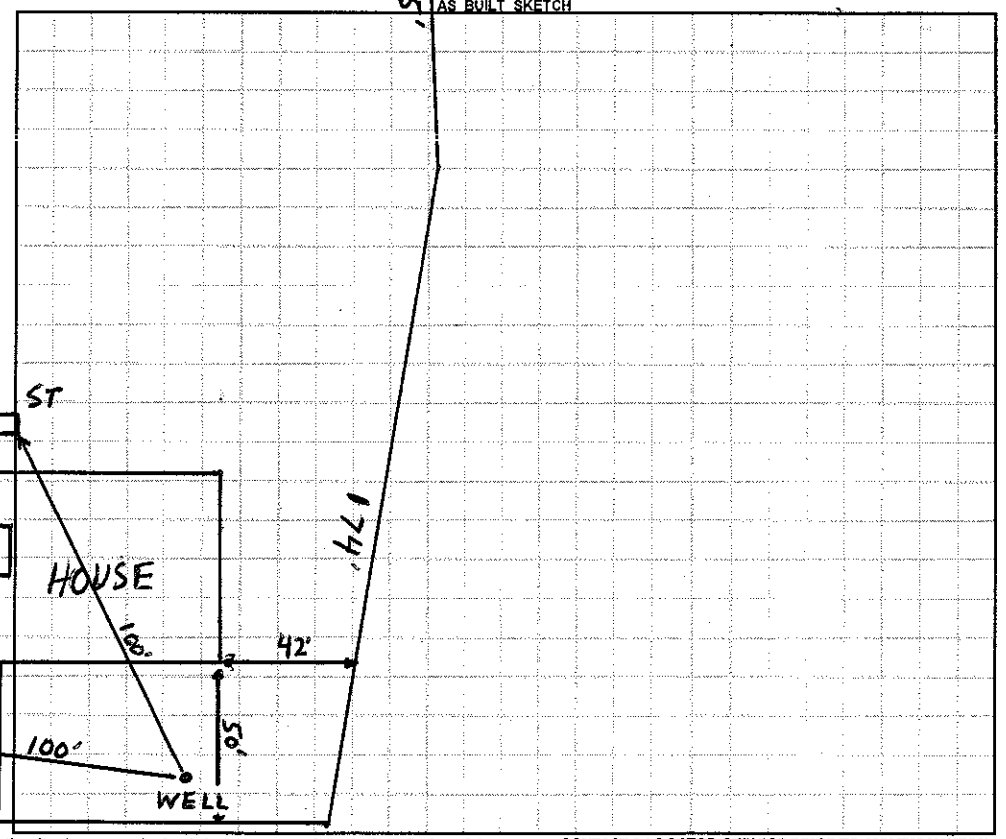

Permit can be suspended or revoked if any false information is supplied toward securing the permit / any unauthorized changes are made to the site / any unauthorized changes are made in the installation of the system. **CONTACT A LOCATOR SERVICE PRIOR TO ANY EXCAVATION**

☐ **IMPROVEMENT PERMIT** *with plat valid without expiration.* ☑ **IMPROVEMENT PERMIT** *with site plan valid for 60 mos.* ☑ **AUTHORIZATION TO CONSTRUCT** *valid for period equal to IMPROVEMENT PERMIT--not to exceed 60 mo.*

Owner / Applicant Signature: [signature] Date: 1-3-14 Installed by: ORBISON

IMPROVEMENT PERMIT by: [signature] Date: 11-18-13 OPERATION PERMIT by: [signature] Date: APPROVED APR 28 2014

AUTHORIZATION TO CONSTRUCT by: [signature] Date: 1-9-14 Existing System Inspected by: Date:

Health Dept. Copy - WHITE Applicant (Final Approval) - YELLOW Applicant (Conditional Approval) - PINK