#90 ✓ 1:00-1:30

IREDELL COUNTY HEALTH DEPARTMENT

STATESVILLE 704-878-5305 MOORESVILLE 704-664-5281

IMPROVEMENT PERMIT / AUTHORIZATION TO CONSTRUCT / OPERATION PERMIT / EXISTING SYSTEM INSPECTION

PERMIT# 148867 PIN# 4637129892

OWNER OR APPLICANT Jason Hampe DATE 3-13-08

ADDRESS PHONE: Business 336-399-1810 Home

LOCATION Brawley School Rd, TR Blume, TR Patternote (163)

SUBDIVISION Lot 1 BLOCK / SECTION LOT 1509 LOT AREA SITE CLASS PS DESIGN FLOW 360 L.T.A.R.

Septic Tank: 1000 Gallons; STB 794 Date 5-9-97

Pump Tank: 1000 Gallons; PT 27 Date 5-6-97

Pump Make: Goulds Model PE5M Serial No.

Nitrification Field: No Fields ___ Square Feet ___ Linear Feet ___

No Lines ___ Trench Width ___ Max Trench Bottom Depth ___ Gravel Depth ___

☐ New System ☐ Repair ☒ Expansion System Type: I II III IV V VI

System Description: moving tanks

Repair System Description:

Maintenance Agreement Required: ☐ Yes ☒ No

☐ Gravity ☒ Pressure

☐ House/Mod. Home ☐ Mobile Home ☐ Business ☐ Other

No. Bedrooms 3 No. Persons ___ No. Employees ___

Water Supply: ☒ Individual ☐ Public ☐ Community


☐ Slab ☐ Crawl Space ☒ Basement w/plumbing ☐ Basement wo/plumbing

Comments/Conditions: New septic tank + Pump tank to be installed on lake side of house/Tanks must not go over 50' set back from lake + must be 10' min from house

Comments/Conditions: Hook up new supply line to ~~existing~~ supply line

6/19/09 Set new pressure manifold due to other being accidentially destroyed

INITIAL SITE SKETCH

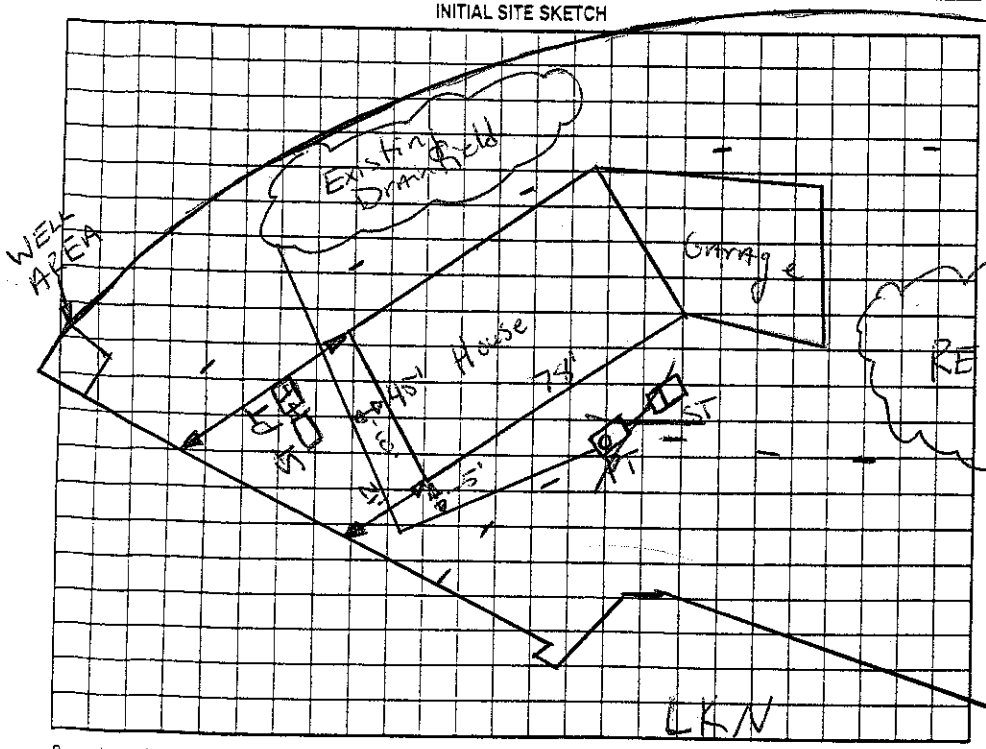

AS BUILT SKETCH

Set Filter & re-set original tanks to side of house

New pump installed. Original permit destroyed

Permit can be suspended or revoked if any false information is supplied toward securing the permit/any unauthorized changes are made to the site/any unauthorized changes are made in the installation of the system. Improvement Permit with plat valid without expiration ☐ Improvement Permit with site plan valid for sixty months ☒ Authorization to Construct is valid for a period equal to that of Improvement Permit – not to exceed sixty months.

Signed: Jason Hampe date 4-1-08

Improvement Permit by: B-A-Ellis date 3-28-08

Authorization to Construct by: B-A-Ellis date 3-28-08

Installed by: Larry Hinkle

Operation Permit by: B-A-Ellis date 6-23-09

Existing System Inspection by: date

HEALTH DEPT. COPY: WHITE OWNER COPY (FINAL): YELLOW OWNER COPY (INITIAL): PINK