IREDELL COUNTY HEALTH DEPARTMENT / STATESVILLE 704-878-5305 MOORESVILLE 704-664-5281

IMPROVEMENT PERMIT / CERTIFICATE OF COMPLETION / OPERATION PERMIT / EXISTING SYSTEM INSPECTION

PROPERTY DESCRIPTION NO. 26249 DATE 6/13/97 TAX MAP NO. 4637078944

OWNER OR CONTRACTOR DEAN LOCKLEAR PHONE: Business _____ Home 664-2147 Watershed: ☐ Yes ☐ No

ADDRESS 151 PATTERSON RD MOORESVILLE NC 28115

LOCATION BRAMLEY SCHOOL RD - TR BLUME RD TR PATTERSON RD - ON LT PAST #151.

SUBDIVISION C L & T BLOCK / SECTION _____ LOT 1984 LOT AREA _____ SITE CLASS 2 DESIGN FLOW 360 L.T.A.R. .3

Septic Tank: 1000 Gallons; STB 734 Date 6/13/97

Pump Tank: 1000 Gallons; PT 27 Date 7/15/97

Pump Make: _____ Model _____ Serial No. _____

Nitrification Field: No Fields 1 Square Feet 900 Linear Feet 240

No Lines 4 @ 50' Trench Width 24" Max Trench Bottom Depth 36" Gravel Depth 12"

☐ New System ☐ Repair System Type: I, II, III, IV, V, VI

System Description: PUMP PANEL (Press Max)

Repair System Description: SAME

Maintenance Agreement Required: ☐ Yes ☐ No

☐ House/Mod. Home ☐ Mobile Home ☐ Business ☐ Other

No. Bedrooms 3 No. Bathrooms 2 No. Employees _____


☐ Slab ☐ Crawl Space ☐ Basement w/plumbing ☐ Basement w/o plumbing

Water Supply: ☐ Individual ☐ Community ☐ Public


Comments:

Comments:

INITIAL SITE SKETCH 1" = 60'

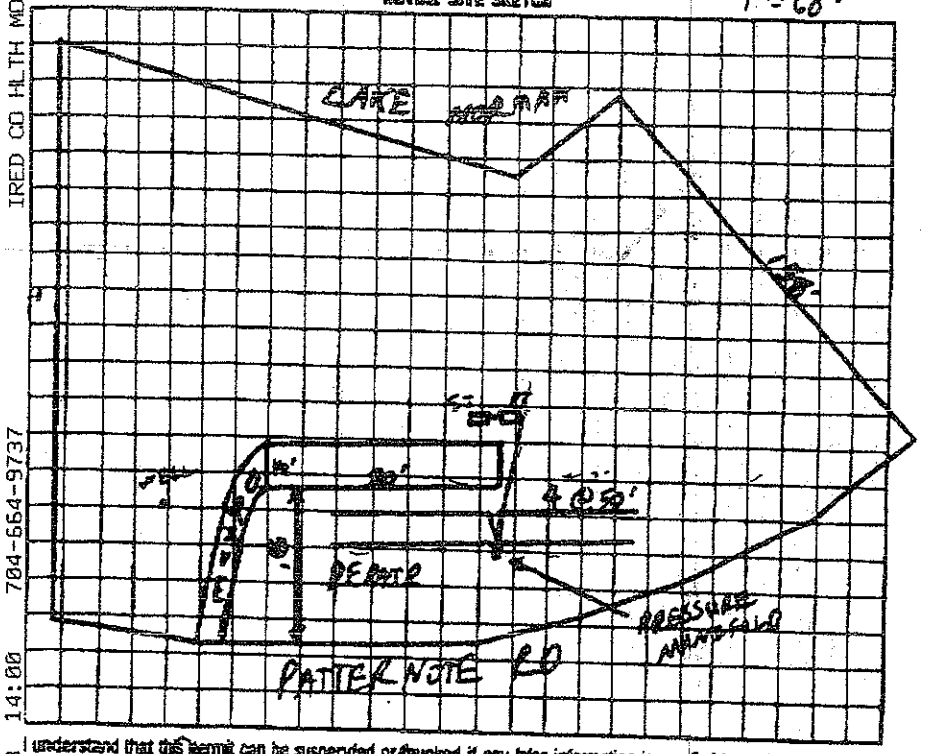

AS BUILT SKETCH

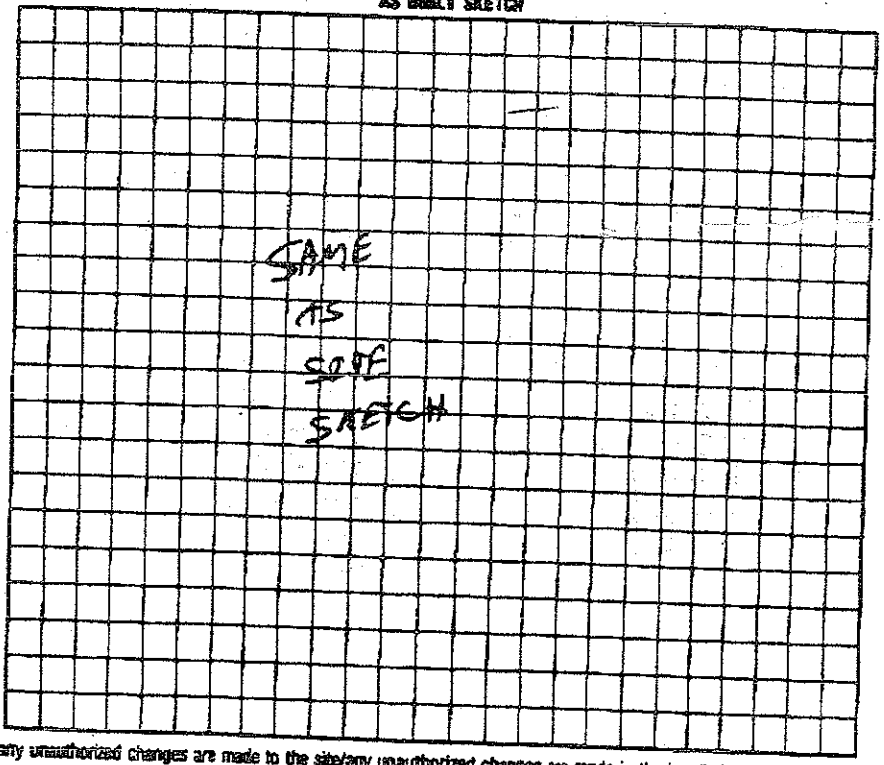

I understand that this permit can be suspended or revoked if any false information is supplied toward securing the permit/any unauthorized changes are made to the site/any unauthorized changes are made in the installation of the system. Improvement Permit is valid for 60 months from date of issuance.

Signed: Dean C. Locklear

Improvement Permit by: C. Ray Tew date 6/13/97

Authorization-Existing System Inspection by: C. Ray Tew date 6/13/97

Consent

Installed by: HENKLE LANDSCAPING

Certificate of Completion by: _____ date _____

Operation Permit by: _____ date _____

HEALTH DEPT. COPY: WHITE INSPECTION COPY (FINAL): GREEN OWNER COPY (FINAL): YELLOW INSPECTION COPY (INITIAL): PINK OWNER COPY (INITIAL): GOLD

IMP Replacement Permit

11/21/2003 14:00 704-664-9737 IRED CO HLTH MOORESV PAGE 02