3:30

IREDELL COUNTY HEALTH DEPARTMENT

STATESVILLE 704-878-5305 MOORESVILLE 704-664-5281

IMPROVEMENT PERMIT / AUTHORIZATION TO CONSTRUCT / OPERATION PERMIT / EXISTING SYSTEM INSPECTION

PERMIT# 115481 PIN# ~~4637131039.000~~ 4637131027.000 DATE 10/10/03

OWNER OR CONTRACTOR NIBLOCK DEVELOPMENT PHONE: Business 331-4745 Home

ADDRESS 300 McBILL AVENUE - CONCORD NC 28027

LOCATION BRAWLEY SCHOOL - TR BLUME - ON LT #133

SUBDIVISION EDGEWATER PK. BLOCK / SECTION LOT 10 LOT AREA 1.91AC SITE CLASS. 1S DESIGN FLOW 480GPD L.T.A.R. .36/1.72

Septic Tank: 1000 Gallons; STB 313 Date 12-21-03
Pump Tank: 1000 Gallons; PT 29 Date 1-20-04
Pump Make: Little Giant Model 9EHCIARFS Serial No. 509350
Nitrification Field: No Fields 1 Square Feet 562 Linear Feet 281
No Lines 4 Trench Width 24" Max Trench Bottom Depth 36" Gravel Depth N/A

☑ New System ☐ Repair System Type: I, II, III, (IV), V, VI
System Description: LP PANEL
Repair System Description: SAME
Maintenance Agreement Required: ☑ Yes ☐ No

☑ House/Mod. Home No. Bedrooms 4
☐ Mobile Home No. Bathrooms 4
☐ Business No. Employees
☐ Other


Water Supply: ☑ Individual ☐ Public ☐ Community

☐ Slab ☑ Crawl Space ☐ Basement w/plumbing ☐ Basement wo/plumbing


Comments:/Conditions:

Comments:/Conditions: 3/16" hole drilled
Checked tanks, lines & pressure

1"=50' INITIAL SITE SKETCH

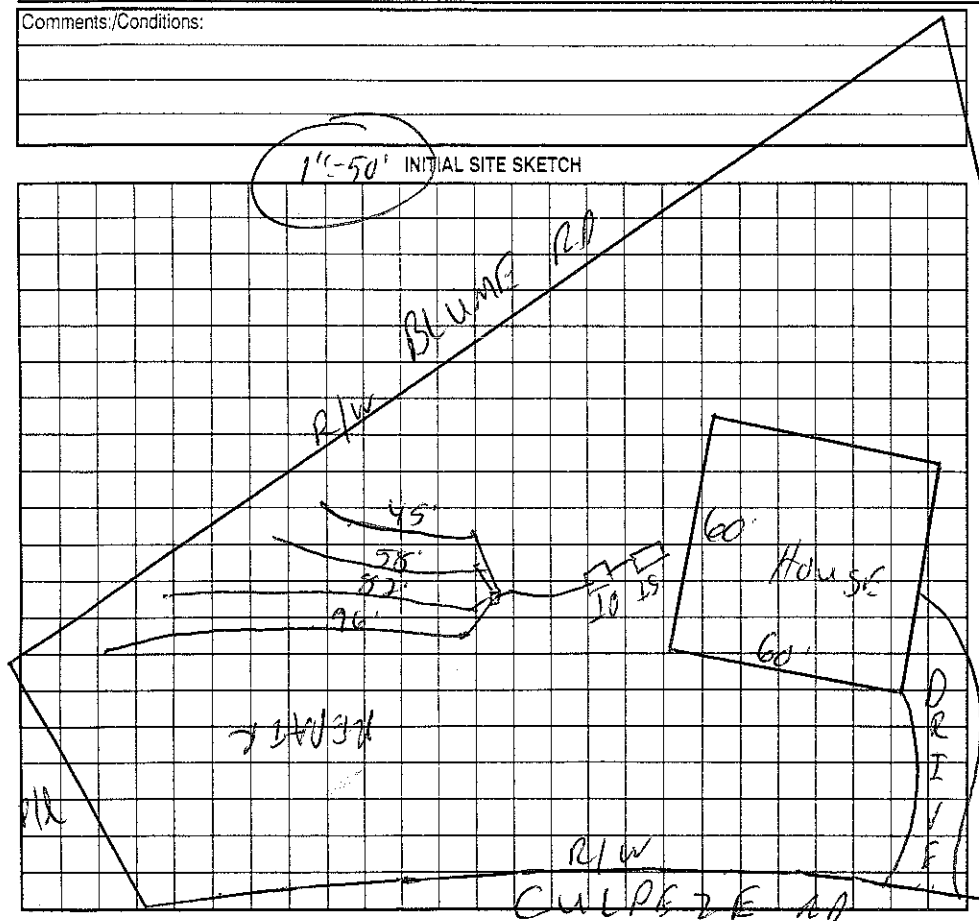

AS BUILT SKETCH

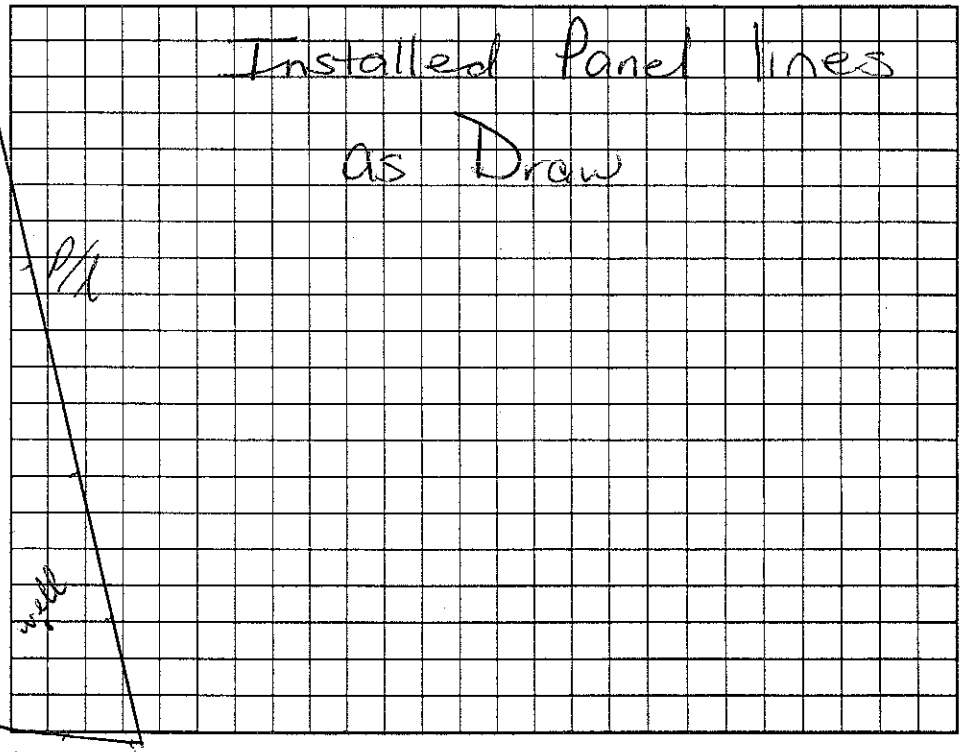

Permit can be suspended or revoked if any false information is supplied toward securing the permit/any unauthorized changes are made to the site/any unauthorized changes are made in the installation of the system. Improvement Permit with plat valid without expiration. Improvement Permit with site plan valid for sixty months. Authorization to Construct is valid for a period equal to that of Improvement Permit -- not to exceed sixty months.

Signed: Pat Carpenter date 10/14/03 Installed by: Richard Abernathy RS

Improvement Permit by: RS date 10/20/03 Operation Permit by: [illegible] date 3/9/04

Authorization to Construct by: RS date 12/4/03 Existing System Inspection by: date

HEALTH DEPT. COPY: WHITE OWNER COPY (FINAL): YELLOW OWNER COPY (INITIAL): PINK