IREDELL COUNTY HEALTH DEPARTMENT

Statesville Office (704) 878-5305 Mooresville Office (704) 660-3625 PERMIT # 208933

IMPROVEMENT PERMIT / AUTHORIZATION TO CONSTRUCT / OPERATION PERMIT / EXISTING SYSTEM

PIN # 4637131027

APPLICANT: CHAMPION WINDOW CO. APPLICANT ADDRESS: 9100 PERIMETER WOODS DR CHARLOTTE NC 28216

SITE ADDRESS: 133 CULPEZE - MOORESVILLE PHONE: ALT. PHONE:

SITE DIRECTIONS: BRAWLEY SCHOOL RD - TR BLUME - TL CULPEZE - 1ST ON LT

SUBDIVISION: EDGEWATER PARK SECTION: 2 LOT # 10 LOT AREA: .91AC DESIGN FLOW: 480 L.T.A.R.: .3

Septic Tank ~~(gal)~~ STB Date

Pump Tank (gal) PT EXISTING Date

Pump Make Model Serial # ~~-~~

Nitrification Fields # Lines Linear Ft:

Trench Width Max. Trench Bottom Depth Gravel Depth

☑ New System ☐ Repair ☐ Expansion System Type: I II III IV V VI

System Description: LP PPBPS

Repair System Description: SAME

Maintenance Agreement Required: ☑ YES ☐ ~~NO~~

☐ GRAVITY ☑ PRESSURE

☑ Residence No. Bedrooms 4

☐ Business No. Persons 8

☐ Other No. Employees

☐ Slab ☑ Crawl Space

☐ Basement w/plumbing ☐ Basement w/o plumbing

Water Supply: ☑ Private ☐ Public ☐ Community

Comments / Conditions:

OUTBUILDING OVER EX. SYSTEM BUT IT DOES NOT AFFECT WHAT IS BEING APPLIED FOR

INITIAL SITE SKETCH

AS BUILT SKETCH

SEE TONEY JACOBS & ASSOCIATES DESIGN

Permit can be suspended or revoked if any false information is supplied toward securing the permit / any unauthorized changes are made to the site / any unauthorized changes are made in the installation of the system. **CONTACT A LOCATOR SERVICE PRIOR TO ANY EXCAVATION**


☐ **IMPROVEMENT PERMIT** *with plat valid without expiration.* ☐ **IMPROVEMENT PERMIT** *with site plan valid for 60 mos.* ☐ **AUTHORIZATION TO CONSTRUCT** *valid for period equal to IMPROVEMENT PERMIT--not to exceed 60 mo.*

Owner / Applicant Signature: Tony Jacobs Date: 4-8-15 Installed by:

IMPROVEMENT PERMIT by: Date: OPERATION PERMIT by: Date:


AUTHORIZATION TO CONSTRUCT by: Date: Existing System Inspected by: C. [illegible] Date: 4/6/15

Health Dept. Copy - WHITE Applicant (Final Approval) - YELLOW Applicant (Conditional Approval) - PINK

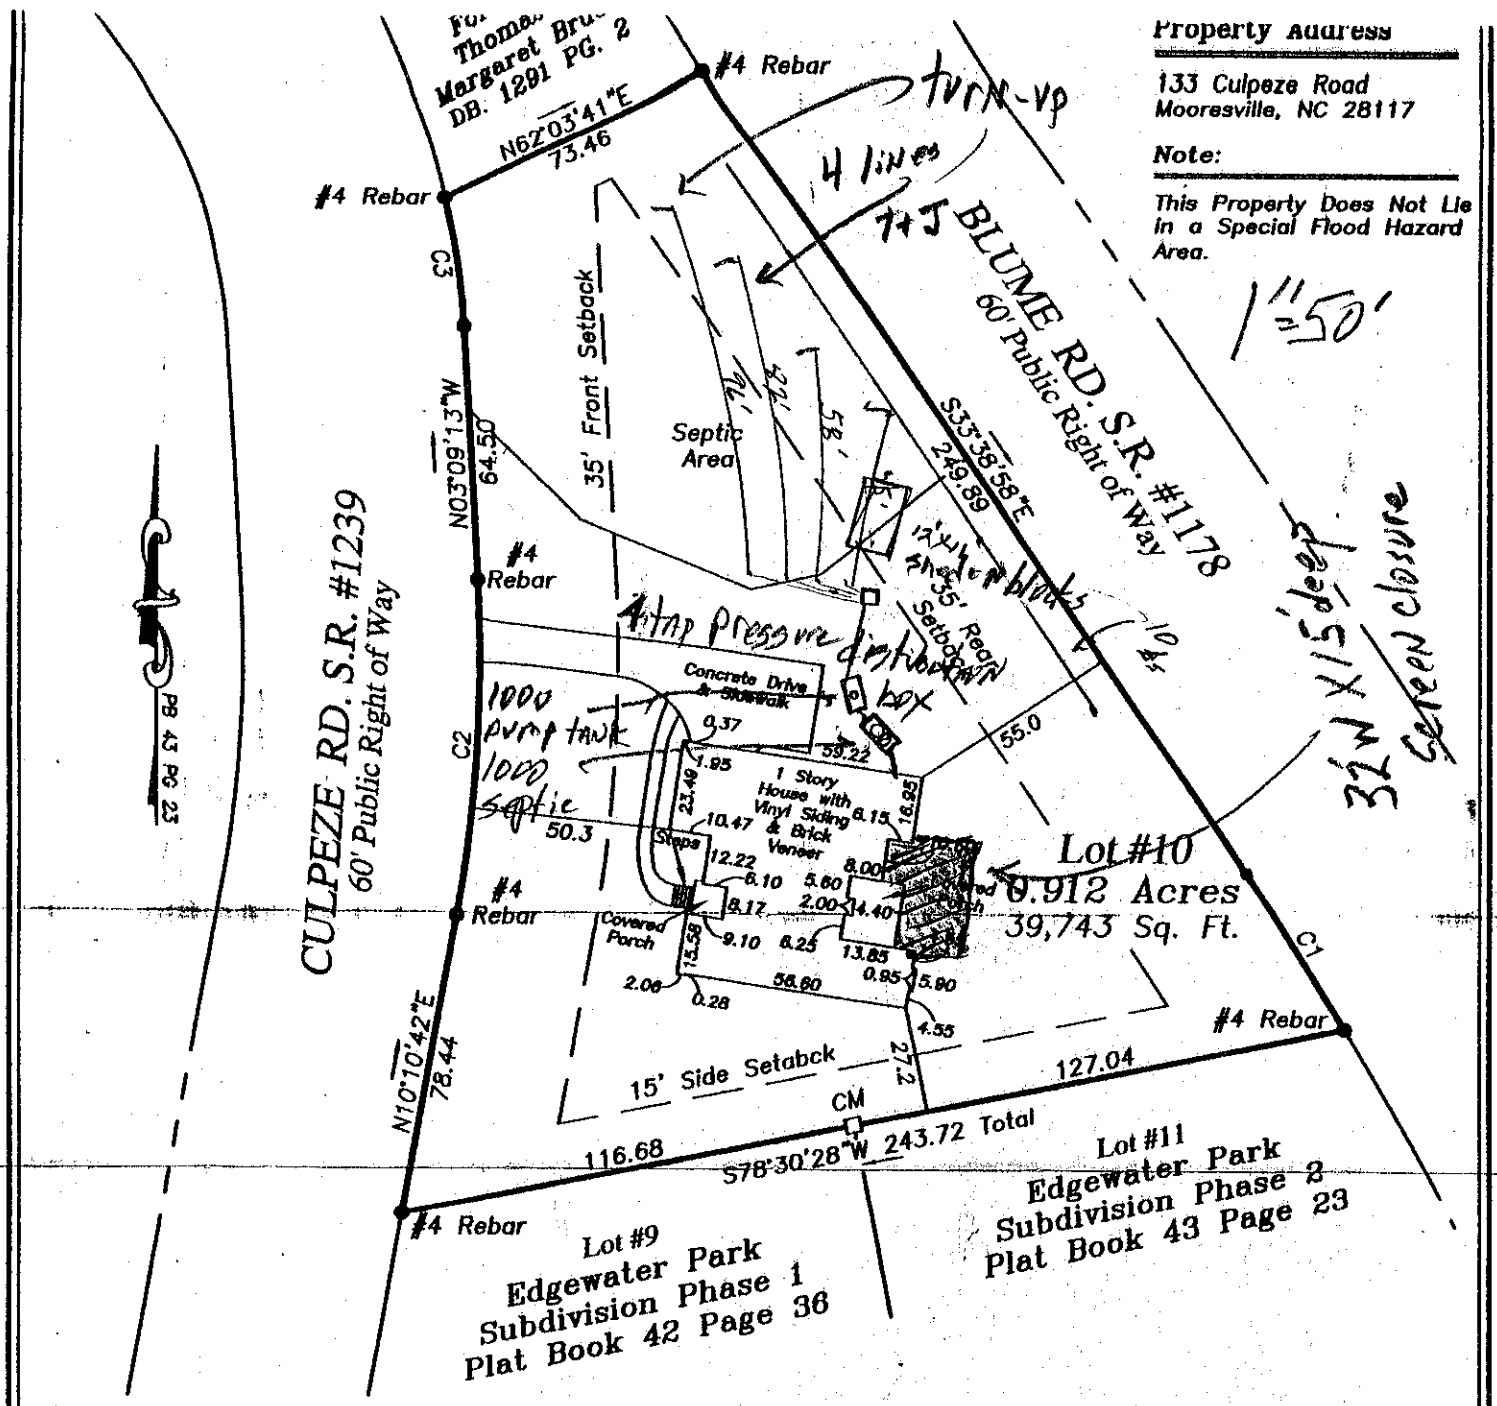

Owner

Niblock Development Corp.
300 McGill Avenue, NW
Concord, N.C. 28027
(704) 331-4745

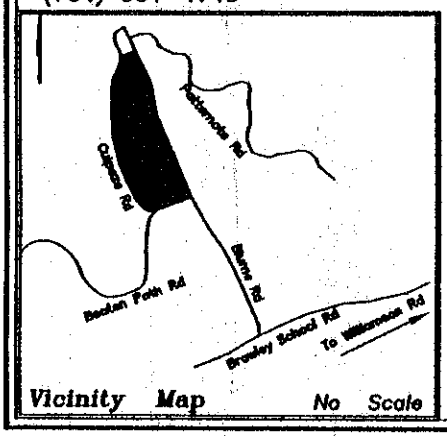

Vicinity Map No Scale

Boundary & Physical Survey Plat for

Doug Cole

Davidson Township Iredell County N. C.
Scale 1"= 50' Date of Survey March 19th, 2004

Reference
Plat Book 43 Page 23 Lot #10 Edgewater Park Subdivision

GRAPHIC SCALE
50 0 25 50 100 200
(IN FEET)
1 inch = 50 ft.

PIEDMONT DESIGN ASSOCIATES, P.A.
ENGINEERING – SURVEYING – PLANNING
125 E. Plaza Dr., Suite 104, Mooresville, N.C. 28115
Phone (704) 664-7888 Fax (704) 664-1778

RECEIVED MAR 3 0 2015


Inspection and as-built drawing for Fast Tract
addition of screen porch over existing patio
133 Culpeze Road
Mooresville NC 28117

Permit #115481

Prepared for:
Trevor Tillman
Champion Builders
9100 Perimeter Woods Drive
Charlotte, NC 28216

Prepared by:
Toney C. Jacobs, LSS
Jacobs On-Site Development, Inc.
168 Broadbill Drive
Mooresville, North Carolina 28117
704 662-9845
toneycjacobs@gmail.com

March 29, 2015

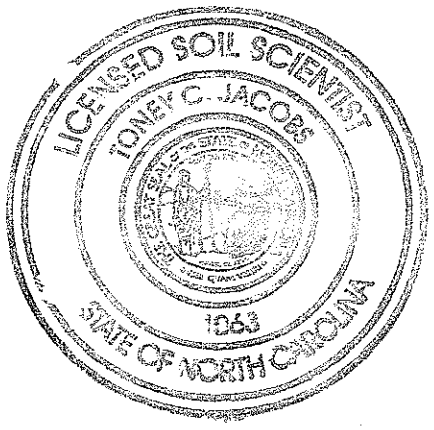

Copy: Mooresville Staff, REHS
Iredell County Health Dept.
(704 660-3625)

Toney C. Jacobs, LSS

133 Culpeze Road

- Lot corners were reflagged
- No part of new construction encumbers existing system or repair
- All components of existing system were as shown on 3-9-2004 permit
- Visual inspection and probing show no signs of system malfunction