REDELL COUNTY HEALTH DEPARTMENT

STATESVILLE 704-878-5305 MOORESVILLE 704-664-5281

IMPROVEMENT PERMIT / AUTHORIZATION TO CONSTRUCT / OPERATION PERMIT / EXISTING SYSTEM INSPECTION

PERMIT# 140018 PIN# 4637134159 DATE 2-23-07

OWNER OR APPLICANT James Brannen PHONE: Business 704-664-4571 Home

ADDRESS 108 Culpeze Rd Mooresville

LOCATION Brawley School Rd TR Blume TR Patternote on right

SUBDIVISION Devonshire BLOCK / SECTION LOT 22 LOT AREA .184 AC SITE CLASS PS DESIGN FLOW 480gpd L.T.A.R. .3 gpd/ft2

Septic Tank: 1000 Gallons; STB 312 Date 12-12-06
Pump Tank: Gallons; PT Date
Pump Make: Model Serial No.
Nitrification Field: No Fields 1 Square Feet Linear Feet 270
No Lines 8@34' Trench Width 24" Max Trench Bottom Depth 36"

☑ New System ☐ Repair ☐ Expansion System Type: I II (III) IV V VI
System Description: PPBPS Gravity
Repair System Description: LP PPBPS
Maintenance Agreement Required: ☐ Yes ☒ No


☑ House/Mod. Home No. Bedrooms 4
☐ Mobile Home No. Persons 8
☐ Business No. Employees
☐ Other

Water Supply: ☑ Individual ☐ Public ☐ Community

Gravel Depth NA ☑ Gravity ☐ Pressure ☐ Slab ☑ Crawl Space ☐ Basement w/plumbing ☐ Basement wo/plumbing

Comments/Conditions: Flow Divider & 2 D-Boxes with Ditch 2-3' wide for pipes as sketched. Low pressure system to be installed if gravity cannot be achieved


INITIAL SITE SKETCH

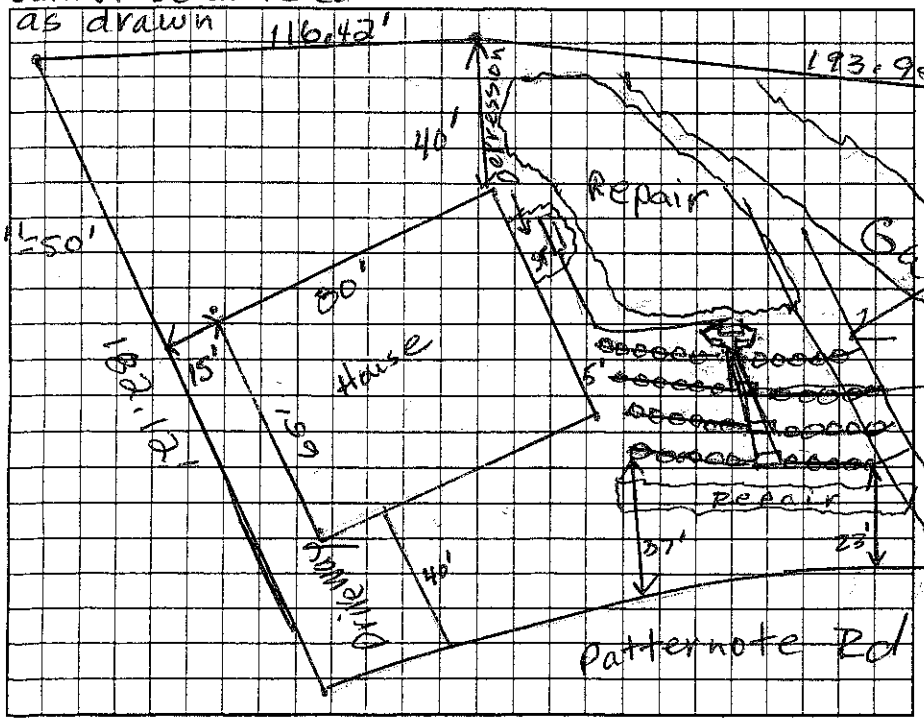

Comments/Conditions: 100' to Drainlines
★ Note: Distribution=D-box with Divider "T" btw each set of lines.

100' well setback

AS BUILT SKETCH

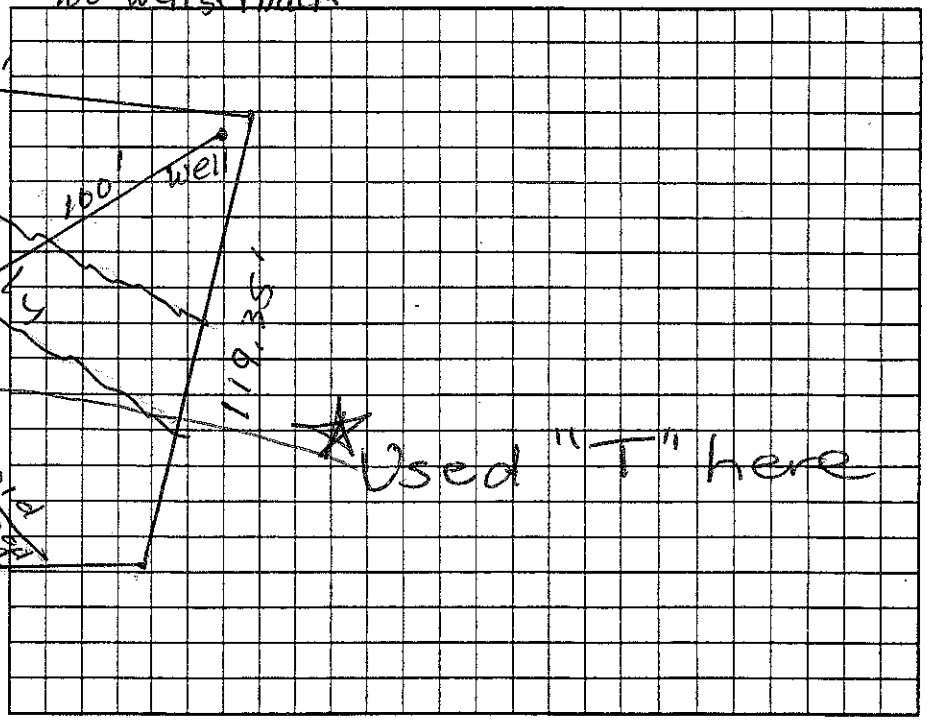

Permit can be suspended or revoked if any false information is supplied toward securing the permit/any unauthorized changes are made to the site/any unauthorized changes are made in the installation of the system. Improvement Permit with plat valid without expiration ☐ Improvement Permit with site plan valid for sixty months ☑ Authorization to Construct is valid for a period equal to that of Improvement Permit – not to exceed sixty months.

Signed: James Brannen date 2-23-07
Improvement Permit by: Judy McNilly date 2-23-07
Authorization to Construct by: Judy McNilly date 2-23-07

Installed by: Richard Abernathy
Operation Permit by: Maria Nelson RS date 8/23/07
Existing System Inspection by: date

HEALTH DEPT. COPY: WHITE OWNER COPY (FINAL): YELLOW OWNER COPY (INITIAL): PINK