IREDELL COUNTY HEALTH DEPARTMENT

STATESVILLE 704-878-5305 375.00 Paid MOORESVILLE 704-664-5281

IMPROVEMENT PERMIT / AUTHORIZATION TO CONSTRUCT / OPERATION PERMIT / EXISTING SYSTEM INSPECTION

PERMIT# 106408 PIN# 4637135421 DATE 6-19-2002

OWNER OR CONTRACTOR Brian Elmore PHONE: Business 904-8318 Brian's Cell Home 799-0601

ADDRESS 123 Patter note Mooresville NC 28117

LOCATION Brawley School Rd TR Blume TR Patternote on left #123

SUBDIVISION Alert BLOCK / SECTION 9 LOT 151 LOT AREA 1.08 Acre SITE CLASS. PS DESIGN FLOW 480gpd L.T.A.R. .3

Septic Tank: 1000 Gallons; STB 794 Date 10-6-02
Pump Tank: 1000 Gallons; PT 27 Date 8-19-02
Pump Make: Myers Model ME50SI Serial No. 25325D07
Nitrification Field: No. Fields 1 Square Feet 540' Linear Feet 270
No. Lines 6 Trench Width 24"-36" Max Trench Bottom Depth 30" Gravel Depth N/A

☒ New System ☐ Repair System Type: I, II, III, IV, V, VI
System Description: Pump-Up-Panel
Repair System Description: See Note
Maintenance Agreement Required: ☒ Yes ☐ No


☒ House/Mod. Home No. Bedrooms 4
☐ Mobile Home No. Bathrooms 4
☐ Business No. Employees
☐ Other
☐ Slab ☐ Crawl Space ☒ Basement w/plumbing ☐ Basement wo/plumbing

Water Supply: ☒ Individual ☐ Public ☐ Community


Comments:/Conditions: Keep Septic System at least 10' from PL, 100' from any well & 50' From lake.

Comments:/Conditions: Note: Lot platted prior to 1983, therefore Repair not required. However if repair needed in future well can be properly abandoned & moved over.

INITIAL SITE SKETCH Scale 1:50

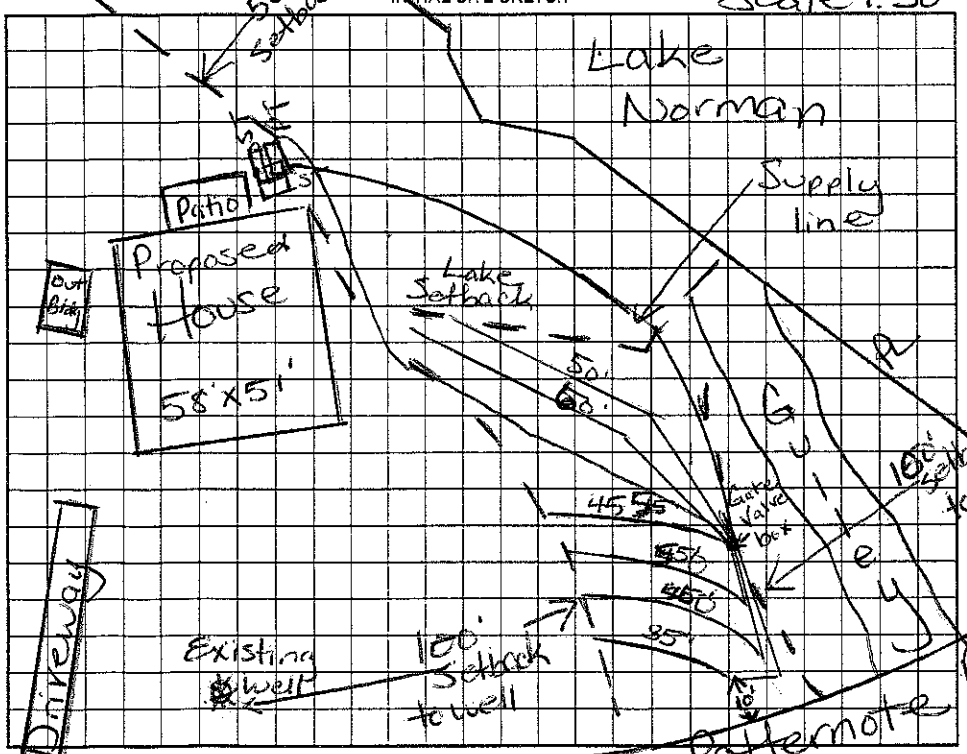

AS BUILT SKETCH

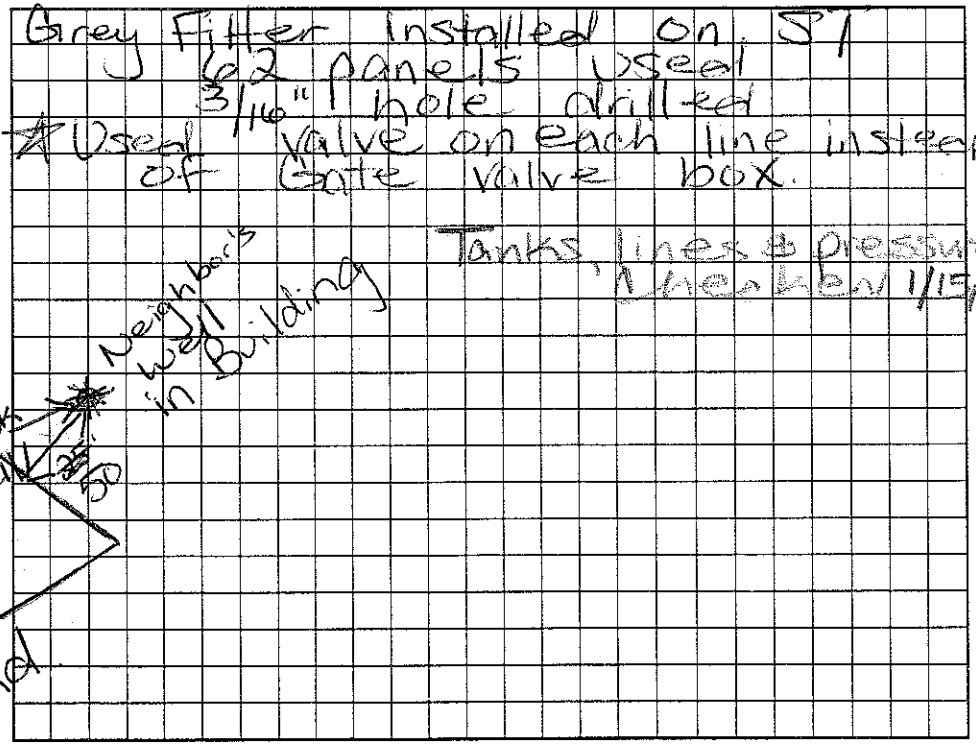

Permit can be suspended or revoked if any false information is supplied toward securing the permit/any unauthorized changes are made to the site/any unauthorized changes are made in the installation of the system. Improvement Permit with plat valid without expiration. Improvement Permit with site plan valid for sixty months. Authorization to Construct is valid for a period equal to that of Improvement Permit – not to exceed sixty months.

Signed: [signature] date 7-3-02 Installed by: Curt Dunning

Improvement Permit by: Maria H. Dolson R.S. date 6/20/02 Operation Permit by: Maria H. Dolson date 3/6/03

Authorization to Construct by: Maria H. Dolson R.S. date 6/20/02 Existing System Inspection by: date

HEALTH DEPT. COPY: WHITE OWNER COPY (FINAL): YELLOW OWNER COPY (INITIAL): PINK