IREDELL COUNTY HEALTH DEPARTMENT

STATESVILLE 704-878-5305 50.00 Paid MOORESVILLE 704-664-5281

IMPROVEMENT PERMIT / AUTHORIZATION TO CONSTRUCT / OPERATION PERMIT / EXISTING SYSTEM INSPECTION

PERMIT# 101579 PIN# 4637-21-4601.23 4637136027 DATE June 9, 03

OWNER OR CONTRACTOR Mike Kidd PHONE: Business 1034-7284 Home

ADDRESS 463 Sundown Rd Mooresville N.C. 28117

LOCATION Brawley Sch Rd. TR Blume TR Paternote on Right

SUBDIVISION Devonshire BLOCK / SECTION LOT 23 LOT AREA 1.15 ac SITE CLASS. PS DESIGN FLOW 360gpd L.T.A.R. .3

Septic Tank: 1000 Gallons; STB 312 Date 6-14-03
Pump Tank: 1000 Gallons; PT 27 Date 4-19-03
Pump Make: Myers Model ME50S-1 Serial No 25325D007
Nitrification Field: No Fields 1 Square Feet 400/600 Linear Feet 200
No Lines 4@50' Trench Width 24" min 36" max Max Trench Bottom Depth 36" Gravel Depth N/A

☑ New System ☐ Repair System Type: I, II, III, IV, V, VI
System Description: PM - PPBPS
Repair System Description: LP PPBPS
Maintenance Agreement Required: ☐ Yes ☑ No Initially


☑ House/Mod. Home No. Bedrooms 3
☐ Mobile Home No. Bathrooms 2½
☐ Business No. Employees
☐ Other
☐ Slab ☐ Crawl Space ☐ Basement w/plumbing ☑ Basement wo/plumbing

Water Supply: ☑ Individual ☐ Public ☐ Community

Comments:/Conditions: OR 36" max 9"oc

Comments:/Conditions: Lines & tanks 7/17/03 MD
Pressure tested 7/30/03 MD

INITIAL SITE SKETCH

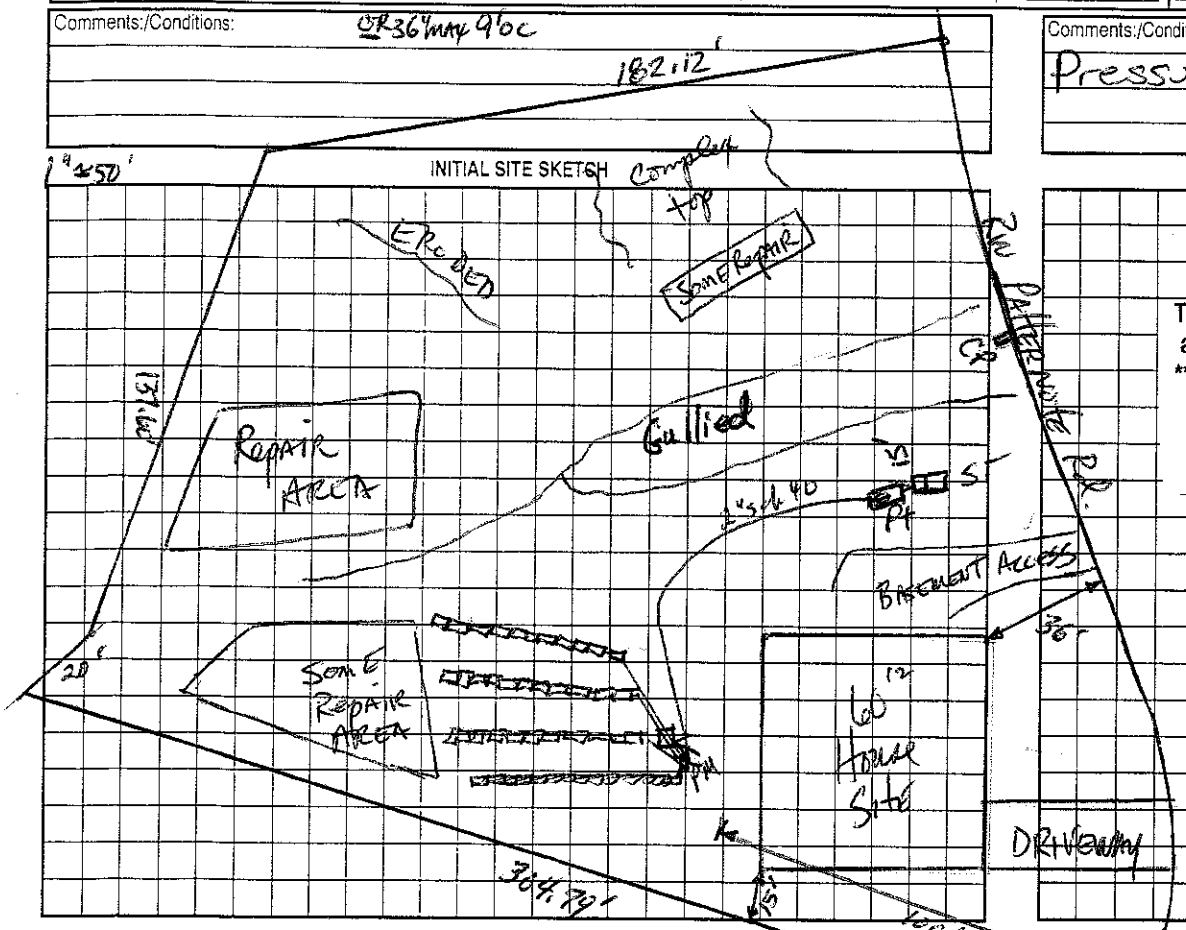

AS BUILT SKETCH

The proposed GARAGE addition does not appear to impact the existing septic system.
**NOTE: BATH ROOM DOWN STAIRS
R.S.
Date: 1-2-09
ICHD-Environmental Health Division

Permit can be suspended or revoked if any false information is supplied toward securing the permit/any unauthorized changes are made to the site/any unauthorized changes are made in the installation of the system. Improvement Permit with plat valid without expiration. Improvement Permit with site plan valid for sixty months. Authorization to Construct is valid for a period equal to that of Improvement Permit – not to exceed sixty months.

Signed: date 6-12-03 Installed by: Mike Kidd RS

Improvement Permit by: RS date 6-9-03 Operation Permit by: Marvin Hilderbrand date 9/25/03

Authorization to Construct by: RS date 6-9-03 Existing System Inspection by: date

HEALTH DEPT. COPY: WHITE OWNER COPY (FINAL): YELLOW OWNER COPY (INITIAL): PINK