# IREDELL COUNTY HEALTH DEPARTMENT

STATESVILLE 704-878-5305 $330.00 Paid MOORESVILLE 704-664-5281

## IMPROVEMENT PERMIT / AUTHORIZATION TO CONSTRUCT / OPERATION PERMIT / EXISTING SYSTEM INSPECT

PERMIT# 094635 PIN# 4637139095 4637-13-9084 DATE 7-13-04

OWNER OR CONTRACTOR Rick Locklear PHONE: Business (803) 985-8528 Home 664-2147 Larry 634-Hinkle 2450

ADDRESS 151 Patternote Rd. Mooresville, NC

LOCATION Brawley School Rd TR Blume TR Patternote Rd on left #151

SUBDIVISION Cla T BLOCK / SECTION 9 LOT 157 LOT AREA .75 Acre SITE CLASS. PS DESIGN FLOW 360 gpd L.T.A.R. .3

Septic Tank: 1000 Gallons; STB 312 Date 3-14-04
Pump Tank: 1000 Gallons; PT 27 Date 6-10-04
Pump Make: Gouds Model WEO 5121HH Serial No. 6/2/04
Nitrification Field: No Fields 1 Square Feet 600 Linear Feet 200'
No Lines 4 Trench Width 24" Max Trench Bottom Depth 30" Gravel Depth N/A

☒ New System ☐ Repair System Type: I, II, (III), IV, V, VI
System Description: Pump-PM-Panel Block
Repair System Description: LP Panel
Maintenance Agreement Required: ☐ Yes ☐ No


☒ House/Mod. Home No. Bedrooms 3
☐ Mobile Home No. Bathrooms 3
☐ Business No. Employees
☐ Other
☐ Slab ☐ Crawl Space ☒ Basement w/plumbing ☐ Basement wo/plumbing

Water Supply: ☒ Individual ☐ Public ☐ Community


Comments:/Conditions: 151.9' Lake Norman 29.86

Comments:/Conditions: Checked tanks & lines 7/22/04 ~67' to well

INITIAL SITE SKETCH

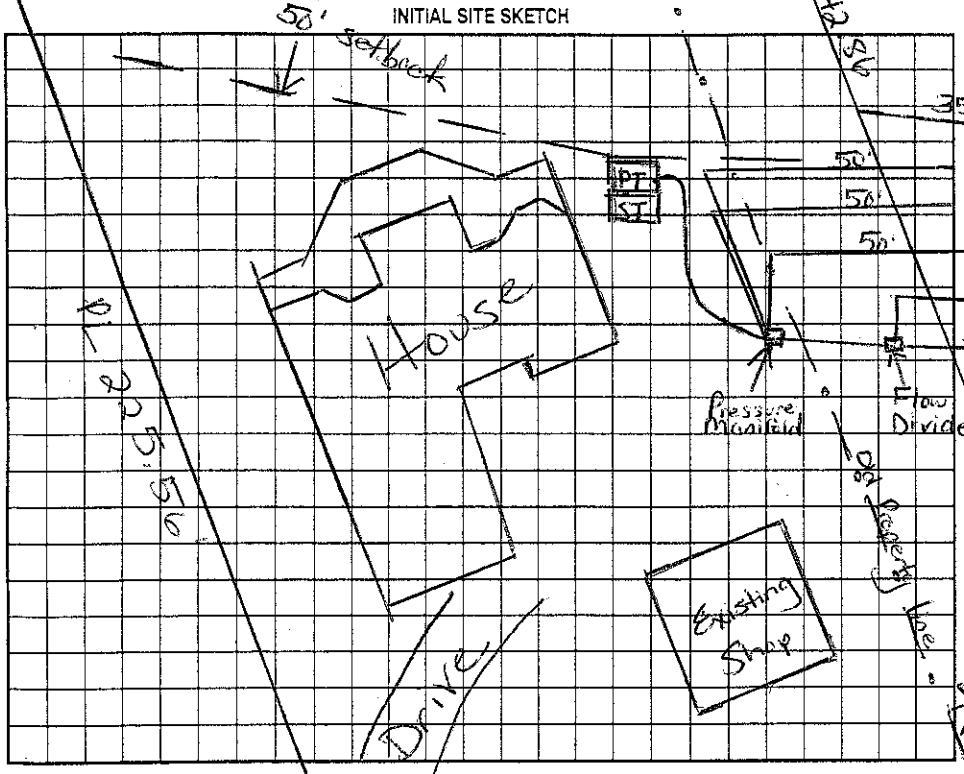


Scale 1:40 AS BUILT SKETCH

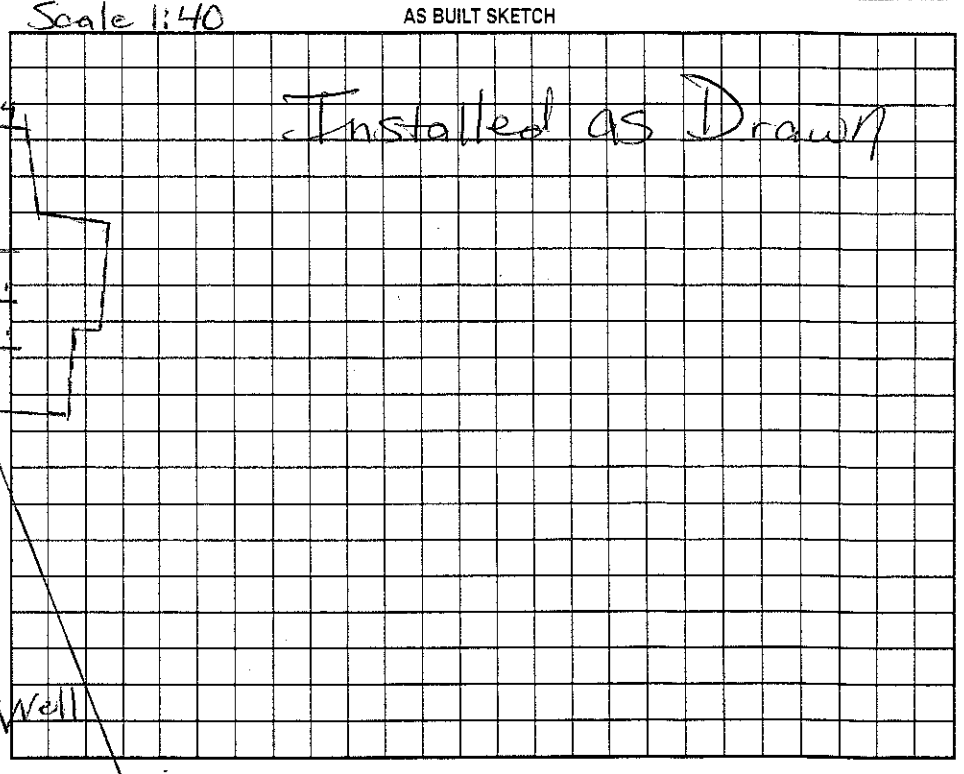


Permit can be suspended or revoked if any false information is supplied toward securing the permit/any unauthorized changes are made to the site/any unauthorized changes are made in the installation of the system. Improvement Permit with plat valid without expiration. Improvement Permit with site plan valid for sixty months. Authorization to Construct is valid for a period equal to that of Improvement Permit – not to exceed sixty months.

Signed: Edith C. Locklear date 7/14/04 Installed by: Larry Hinkle

Improvement Permit by: Maria H. Dotson RS date 7/13/04 Operation Permit by: Wesley Sparks RS. date 8/18/04

Authorization to Construct by: Maria H. Dotson RS date 7/13/04 Existing System Inspection by: date

HEALTH DEPT. COPY: WHITE OWNER COPY (FINAL): YELLOW OWNER COPY (INITIAL): PINK