IREDELL COUNTY HEALTH DEPARTMENT

Statesville Office (704) 878-5305 Mooresville Office (704) 660-3625 PERMIT # 2146662

IMPROVEMENT PERMIT / AUTHORIZATION TO CONSTRUCT / OPERATION PERMIT / EXISTING SYSTEM

PIN # 4637-13-9341

APPLICANT: WILLIAM LUCAS APPLICANT ADDRESS: 12711 KANE ALEXANDER DR. HUNTERSVILLE

SITE ADDRESS: 143 PATTERNOTE PHONE: 704-576-3887 ALT. PHONE:

SITE DIRECTIONS: BSR BLUME, TR PATTERNOTE, ON L

SUBDIVISION: CLET SECTION: 9 LOT # 155 LOT AREA: .83 AC DESIGN FLOW: 360 L.T.A.R.:

Septic Tank ____ (gal) STB ____ Date ____
Pump Tank ____ (gal) PT ____ Date ____
Pump Make ____ Model ____ Serial # ____
Nitrification Fields EXISTING # Lines ____ Linear Ft: ____
Trench Width ____ Max. Trench Bottom Depth ____ Gravel Depth ____

☐ New System ☐ Repair ☐ Expansion System Type: I II III IV V VI
System Description: GRAVEL BED
Repair System Description:
Maintenance Agreement Required: ☐ YES ☒ NO
☒ GRAVITY ☐ PRESSURE

☒ Residence ☐ Business ☐ Other ☐ Slab ☐ Basement w/plumbing
No. Bedrooms 3 No. Persons ____ No. Employees ____ ☒ Crawl Space
☐ Basement w/o plumbing

Water Supply: ☒ Private ☐ Public ☐ Community

Comments / Conditions: DO NOT GRINDER PUMP THE ENTIRE HOUSE.

INITIAL SITE SKETCH

SEE PLAN FROM MICHAEL ATHANAS & ASSOCIATES

AS BUILT SKETCH

Permit can be suspended or revoked if any false information is supplied toward securing the permit / any unauthorized changes are made to the site / any unauthorized changes are made in the installation of the system. **CONTACT A LOCATOR SERVICE PRIOR TO ANY EXCAVATION**


☐ **IMPROVEMENT PERMIT** *with plat valid without expiration.* ☒ **IMPROVEMENT PERMIT** *with site plan valid for 60 mos.* ☒ **AUTHORIZATION TO CONSTRUCT** *valid for period equal to IMPROVEMENT PERMIT--not to exceed 60 mo.*

Owner / Applicant Signature: ____ Date: ____ Installed by: ____

IMPROVEMENT PERMIT by: ____ Date: ____ OPERATION PERMIT by: ____ Date: ____

AUTHORIZATION TO CONSTRUCT by: ____ Date: ____ Existing System Inspected by: [signature] Date: 11-30-15

Health Dept. Copy - WHITE Applicant (Final Approval) - YELLOW Applicant (Conditional Approval) - PINK

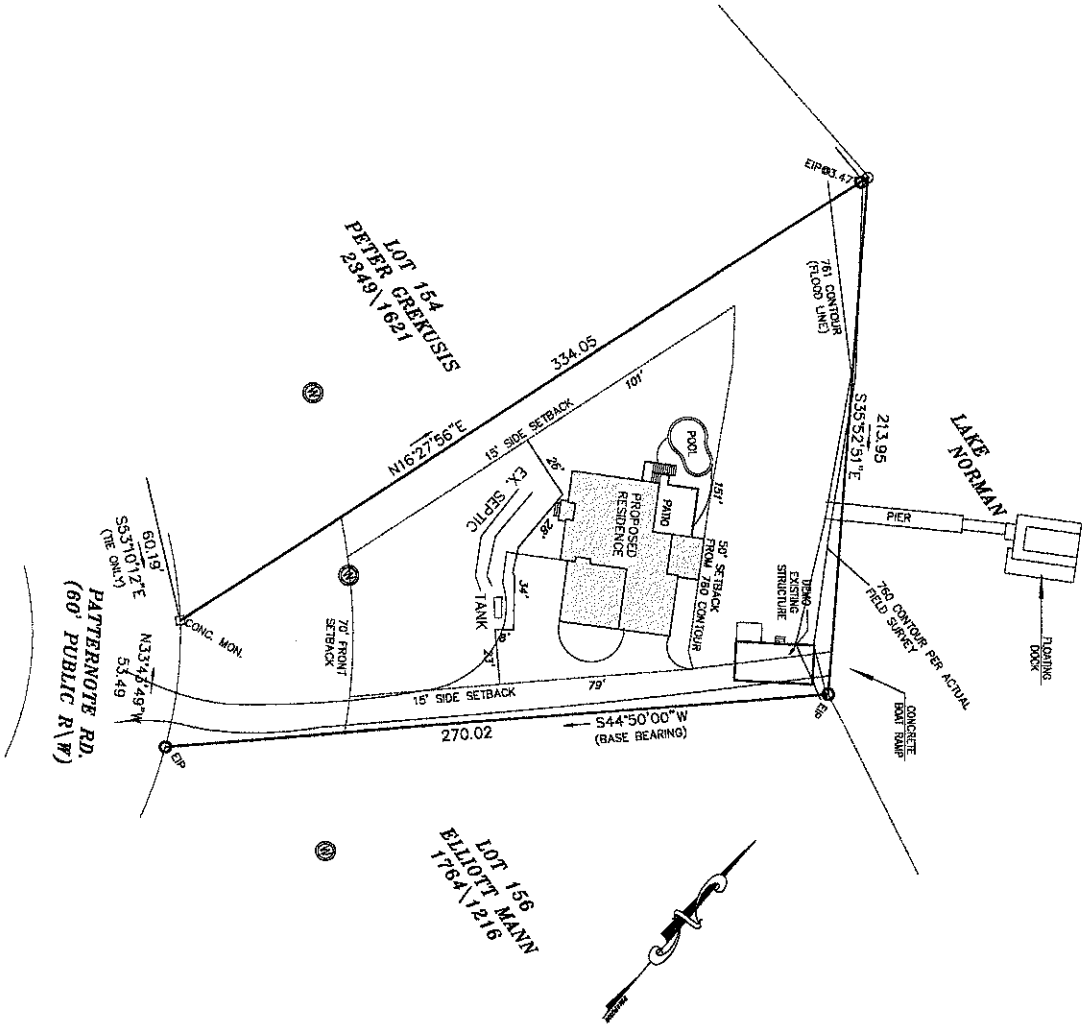

DRAWING: SITE PLAN	SCALE / CLIENT REVIEW	PROJECT: CUSTOM HOME DESIGN for BILL & MARY LUCAS	BUILT BY: WAC CONTRACTING	SEAL:	DRAWN BY: ashley j design custom homes and renovations
PAGE: 3	SCALE: 1" = 20'-0"				P.O. BOX 5423 CHARLOTTE, NC 28299 WWW.ASHLEYJDESIGN.COM 704-858-0682