IREDELL COUNTY HEALTH DEPARTMENT


ENVIRONMENTAL HEALTH DIVISION

PAGE 2: *SITE PLAN WORKSHEET*

SEE THE "SAMPLE SITE PLAN" BELOW. ***INCOMPLETE SITE PLANS WILL BE RETURNED TO YOU FOR COMPLETION AND MAY RESULT IN A DELAY IN THE ISSUANCE OF YOUR SEPTIC SYSTEM PERMIT!!!***

Place an (X) beside each item as you complete the site plan:

( ) Property Line measurements are clearly identified
( ) All proposed structures are indicated
( ) Front and side setbacks from property line
( ) Preferred driveway location and well location
( ) Area you prefer your septic system to be placed
( ) North arrow, or other sufficient indicator of direction

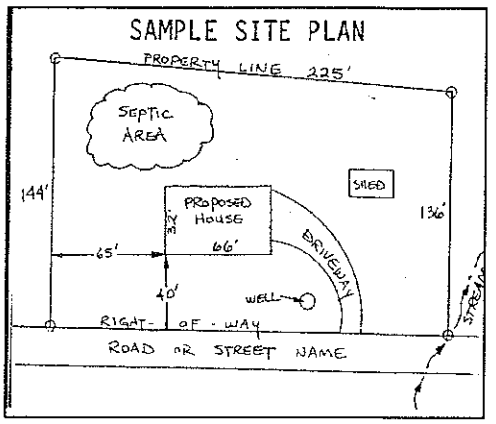

Circle N/A on the following if appropriate:

Location of septic systems and wells within 100' of your property	N/A
Location of easements and rights of ways on your property	N/A
Location of any designated wetlands on the property	N/A

USE THIS SPACE TO DRAW YOUR SITE PLAN

Show: proposed house or business footprint, wells, water lines, patios, pools and decks, and any other item that will occupy space on the site

See Attached Plan

Signature: _____

Property owner or owner's legal representative signature (SIGNATURE REQUIRED)

11/17/2015

DATE

213.35
S32° 52'51"E
PIER
760 CONTOUR PER AC
FIELD SURVEY
CONCRETE
BOAT RAMP
EIP@3.47'
761 CONTOUR
(FLOOD LINE)
EIP
DEMO
EXISTING
STRUCTURE
50' SETBACK
FROM 760 CONTOUR
POOL
PATIO
PROPOSED
RESIDENCE
S74° 50'10"W
(BASE BEARING)
15' SIDE SETBACK
EX. SEPTIC
TANK
15' SIDE SETBACK
N16° 27'55"E
70' FRONT
SETBACK
CONC. MON.
EIP
60.19'
S53° 10'12"E
(TIE ONLY)
N33° 45'49"W
53.49
LOT 154
PETER GREKUSIS
2349\1621
LOT 156
ELLIOTT
1764\
PATTERNOTE RD.
(60' PUBLIC R\W)
Scale
1"=40'

IREDELL COUNTY HEALTH DEPARTMENT

TV3 1139341

STATESVILLE 704-878-5305 MOORESVILLE 704-664-5281

IMPROVEMENT PERMIT / CERTIFICATE OF COMPLETION / OPERATION PERMIT / EXISTING SYSTEM INSPECTION

PROPERTY DESCRIPTION NO 17530 DATE Dec 6, '93 TAX MAP NO. 2L5A 155 Watershed: ☐ Yes ☐ No

OWNER OR CONTRACTOR Jimmy & Joyce Page PHONE: Business _____ Home _____

ADDRESS _____

LOCATION 1100 TR 128 (Blume) TR Patterson ¼ mile on left

SUBDIVISION Crescent Ln. BLOCK / SECTION 9 LOT 155 LOT AREA _____ SITE CLASS. _____ DESIGN FLOW _____ L.T.A.R. _____

Septic Tank: EXISTING Gallons; STB _____ Date _____

Pump Tank: _____ Gallons; PT _____ Date _____

Pump Make: _____ Model _____ Serial No. _____

Nitrification Field: No Fields EXISTING Square Feet _____ Linear Feet _____

No Lines _____ Trench Width _____ Max Trench Bottom Depth _____ Gravel Depth _____

☐ New System ☐ Repair System Type: I, II, III, IV, V, VI

System Description: _____

Repair System Description: _____

Maintenance Agreement Required: ☐ Yes ☐ No

☐ House/Mod. Home No. Bedrooms 3

☑ Mobile Home No. Bathrooms 2

☐ Business No. Employees _____

☐ Other _____


☐ Slab ☑ Crawl Space ☐ Basement w/plumbing ☐ Basement wo/plumbing

Water Supply: ☑ Individual ☐ Community ☐ Public


Comments: Maintain at least 5' separation between septic system with new double wide home.

Comments: Existing septic system shown on sketch of mobile home with double wide. Unable to locate drainfield by probing due to depth.

INITIAL SITE SKETCH

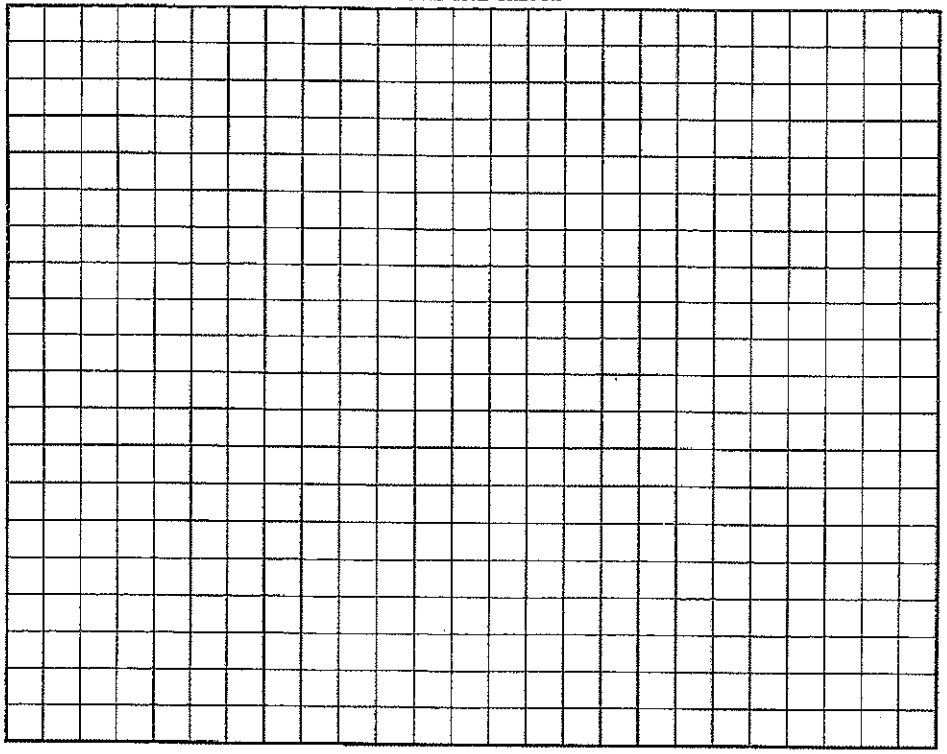

AS BUILT SKETCH

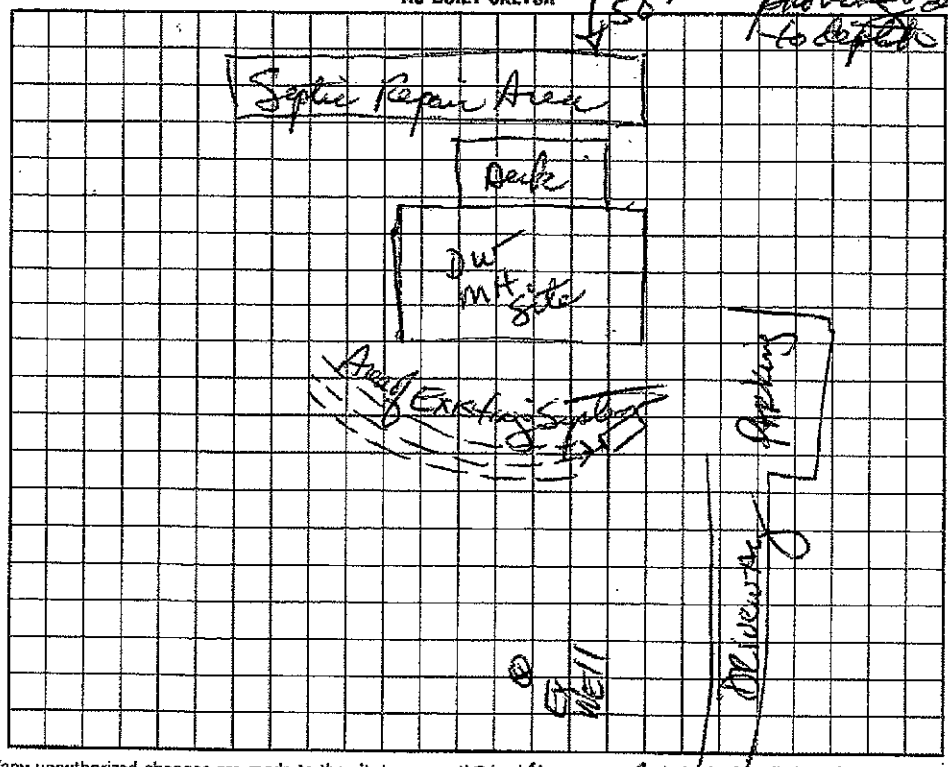

I understand that this permit can be suspended or revoked if any false information is supplied toward securing the permit/any unauthorized changes are made to the site/any unauthorized changes are made in the installation of the system. Improvement Permit is valid for 60 months from date of issuance.

Signed: _____

Improvement Permit by: _____ date _____

Existing System Inspection by: [signature] RS date 12/6/93

Installed by: Patterson

Certificate of Completion by: _____ date _____

Operation Permit by: _____ date _____

HEALTH DEPT. COPY: WHITE INSPECTION COPY (FINAL): GREEN OWNER COPY (FINAL): YELLOW INSPECTION COPY (INITIAL): PINK OWNER COPY (INITIAL): GOLD