IREDELL COUNTY HEALTH DEPARTMENT

Statesville Phone TR 3-7271 Mooresville Phone NO 3-1271

PERMIT TO INSTALL SEPTIC TANK

Permit NO. _____ Permit Date 19 Oct. 1964.

Owner Mr. John. Rea Morrison Address 1612 Elizabeth Ave. Charl. N.C.

Installed By Mr. McCarter. Address Mooresville, N.C.


Location of Property Lot 70 Section 10 Lake Norman.

Tank		Capacity		Length of Lines		Fixtures	
Block	( )	800	( )	150'	( )	No. of Baths	( )
Precast	(X)	900	( )	175'	( )	Dishwasher	( )
		1000	( )	200'	( )	Garbage Grdr.	( )
		1100	( )	225'	( )	Auto-Washer	( )
		1200	( )	250'	( )	Other _____	
		Other 1500		Other 200'			

NOTIFY HEALTH DEPARTMENT AT LEAST EIGHT HOURS BEFORE TANK IS TO BE INSPECTED.

Final Inspection 19 Oct. 1964 Approved (X) Disapproved ( )

Remarks _____

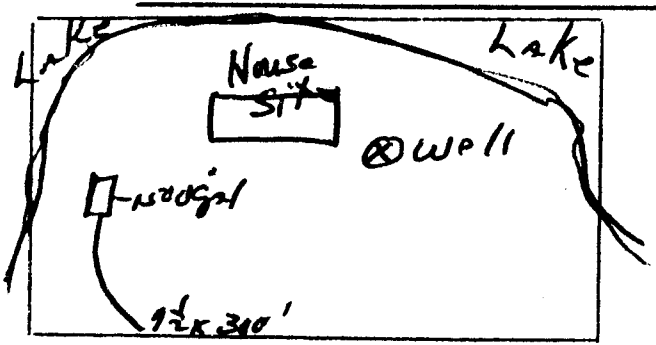

Sketch of Installation

Ray R. Sessoms, R.S.

Sanitarian