IREDELL COUNTY HEALTH DEPARTMENT

STATESVILLE 704-878-5305 MOORESVILLE 704-664-5281

IMPROVEMENT PERMIT / AUTHORIZATION TO CONSTRUCT / OPERATION PERMIT / EXISTING SYSTEM INSPECTION

PERMIT # 17625 PIN # 4637142710 DATE 12-5-2012

OWNER or APPLICANT Atkinson Cust. Homes / Larry Campbell PHONE: Business 704 506 9074 Home:

OWNER or APPLICANT ADDRESS 323 State Park Rd Troutman, NC 28166

LOCATION / DIRECTIONS Hwy 150 W. TL McCrary Rd TR Riverwood TL Revere Dr. Property at end

SUBDIVISION Clark BLOCK / SECTION 10 LOT # 70 LOT AREA DESIGN FLOW L.T.A.R.

Septic Tank 1500 Gallons: STB Date

Pump Tank Gallons: PT Date

Pump Make Model Serial #

Nitrification Field No Fields 1 No Lines Linear Feet 300 Ft

Trench Width 7½ Ft Max. Trench Bottom Depth Gravel Depth

☐ New System ☐ Repair ☐ Expansion System Type (II) III IV V VI

System Description: Exist. Gravity - Conventional

Repair System Description: Modified Convent.

Maintenance Agreement Required ☐ YES ☒ NO

☒ GRAVITY ☐ PRESSURE

☒ Residence No. Bedrooms 3

☐ Business No. Persons

☐ Other No. Employees

☐ Slab ☒ Crawl Space


☐ Basement w/plumbing ☐ Basement w/o plumbing

Water Supply: ☐ Private ☐ Public ☐ Community


Comments / Conditions

Comments / Conditions

INITIAL SITE SKETCH

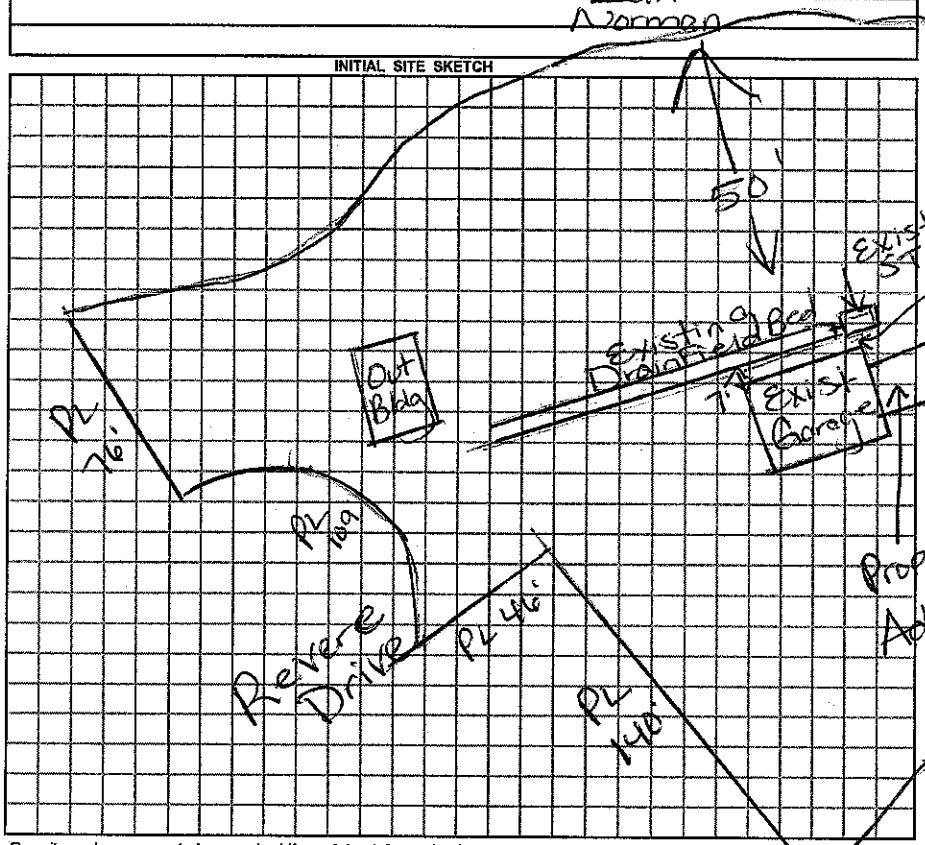

AS BUILT SKETCH

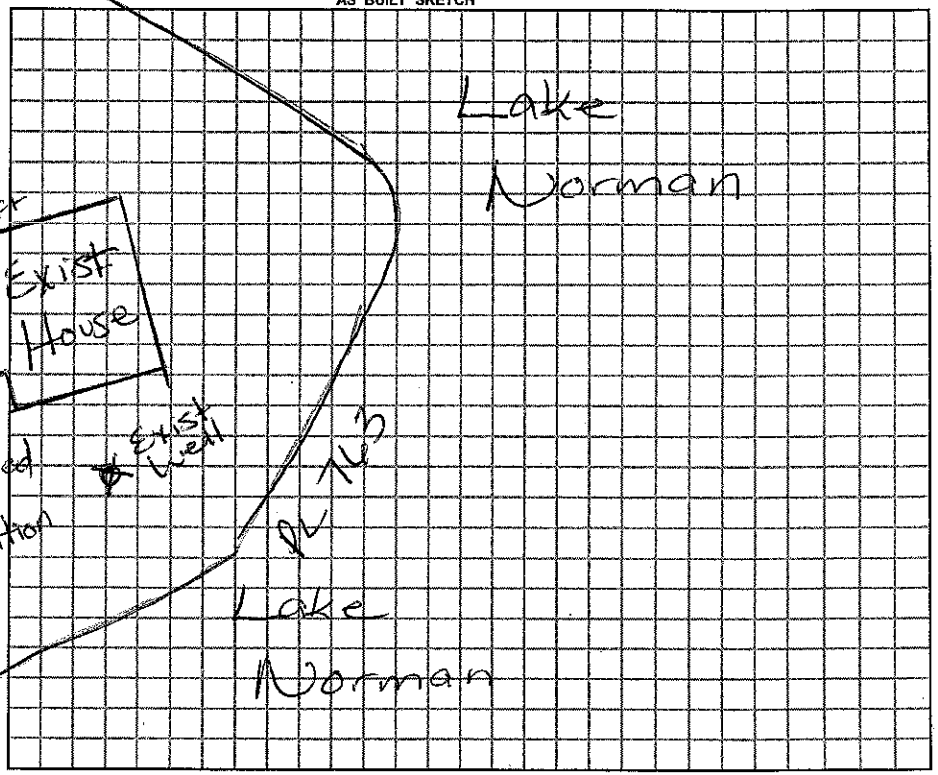

Permit can be suspended or revoked if any false information is supplied toward securing the permit / any unauthorized changes are made to the site / any unauthorized changes are made in the installation of the system.

☐ *IMPROVEMENT PERMIT w / plat valid without expiration.* ☐ *IMPROVEMENT PERMIT w / site plan valid for 60 mos.* ☐ A 60 mo.

The proposed / existing Addition / Remodeling addition does not appear to impact the existing septic system.

**NOTE: Any Building must be at least 5FT from Septic System

Owner / Applicant Signature: Date

Improvement Permit by: Date

Authorzation to Construct by: Date

Installed by

Operation P

Existing Sy

WHITE COP

Maina Dolsen R.S.

Date: 12-5-12

ICHD-Environmental Health Division

YOU SHOULD CONTACT A LOCATOR SERVICE PRIOR TO ANY EXCAVATION.