ALP

IREDELL COUNTY HEALTH DEPARTMENT

Statesville Office (704) 878-5305 Mooresville Office (704) 660-3625 PERMIT # 211392

IMPROVEMENT PERMIT / AUTHORIZATION TO CONSTRUCT / OPERATION PERMIT / EXISTING SYSTEM

PIN # 4637148908

APPLICANT: Rollins Soil & Enviro. Services APPLICANT ADDRESS: P.O. Box 832 Mooresville NC

SITE ADDRESS: 198 Riverwood Bnd Mooresville NC PHONE: 704-746-5040 ALT. PHONE:

SITE DIRECTIONS: 150 W. N McleARY, N Riverwood, First House on L

SUBDIVISION: Riverwood Bend SECTION: LOT # 15 LOT AREA: .740 Acre DESIGN FLOW: 600 GPD Existing L.T.A.R.: Existing

Septic Tank Existing (gal) STB Date
Pump Tank Existing (gal) PT Date
Pump Make Existing Model Serial #
Nitrification Fields Ex. # Lines Existing Linear Ft: Ex.
Trench Width Ex. Max. Trench Bottom Depth Ex. Gravel Depth Sand.

☐ New System ☐ Repair ☐ Expansion System Type: I II III IV V VI
System Description: Existing LP-Panel
Repair System Description: LP-Panel
Maintenance Agreement Required: ☒ YES ☐ NO
☐ GRAVITY ☒ PRESSURE

☒ Residence No. Bedrooms Ex 5
☐ Business No. Persons Ex. 10
☐ Other No. Employees
☐ Slab ☒ Crawl Space
☐ Basement w/plumbing ☐ Basement w/o plumbing

Water Supply: ☒ Private ☐ Public ☐ Community

Comments / Conditions: System Appeared To Be Functioning At Time Of Inspection.

INITIAL SITE SKETCH

See Attached Approved Design Submitted By Rollins Soil & Environmental Services.

Dated APPROVED JUN 25 2015

AS BUILT SKETCH

Permit can be suspended or revoked if any false information is supplied toward securing the permit / any unauthorized changes are made to the site / any unauthorized changes are made in the installation of the system. **CONTACT A LOCATOR SERVICE PRIOR TO ANY EXCAVATION**


☐ **IMPROVEMENT PERMIT** *with plat valid without expiration.* ☐ **IMPROVEMENT PERMIT** *with site plan valid for 60 mos.* ☐ **AUTHORIZATION TO CONSTRUCT** *valid for period equal to IMPROVEMENT PERMIT--not to exceed 60 mo.*

Owner / Applicant Signature: Date: 6/30/15 Installed by:

IMPROVEMENT PERMIT by: Date: OPERATION PERMIT by: Date:

AUTHORIZATION TO CONSTRUCT by: Date: Existing System Inspected by: APPROVED Date JUN 25 2015

Health Dept. Copy - WHITE Applicant (Final Approval) - YELLOW Applicant (Conditional Approval) - PINK

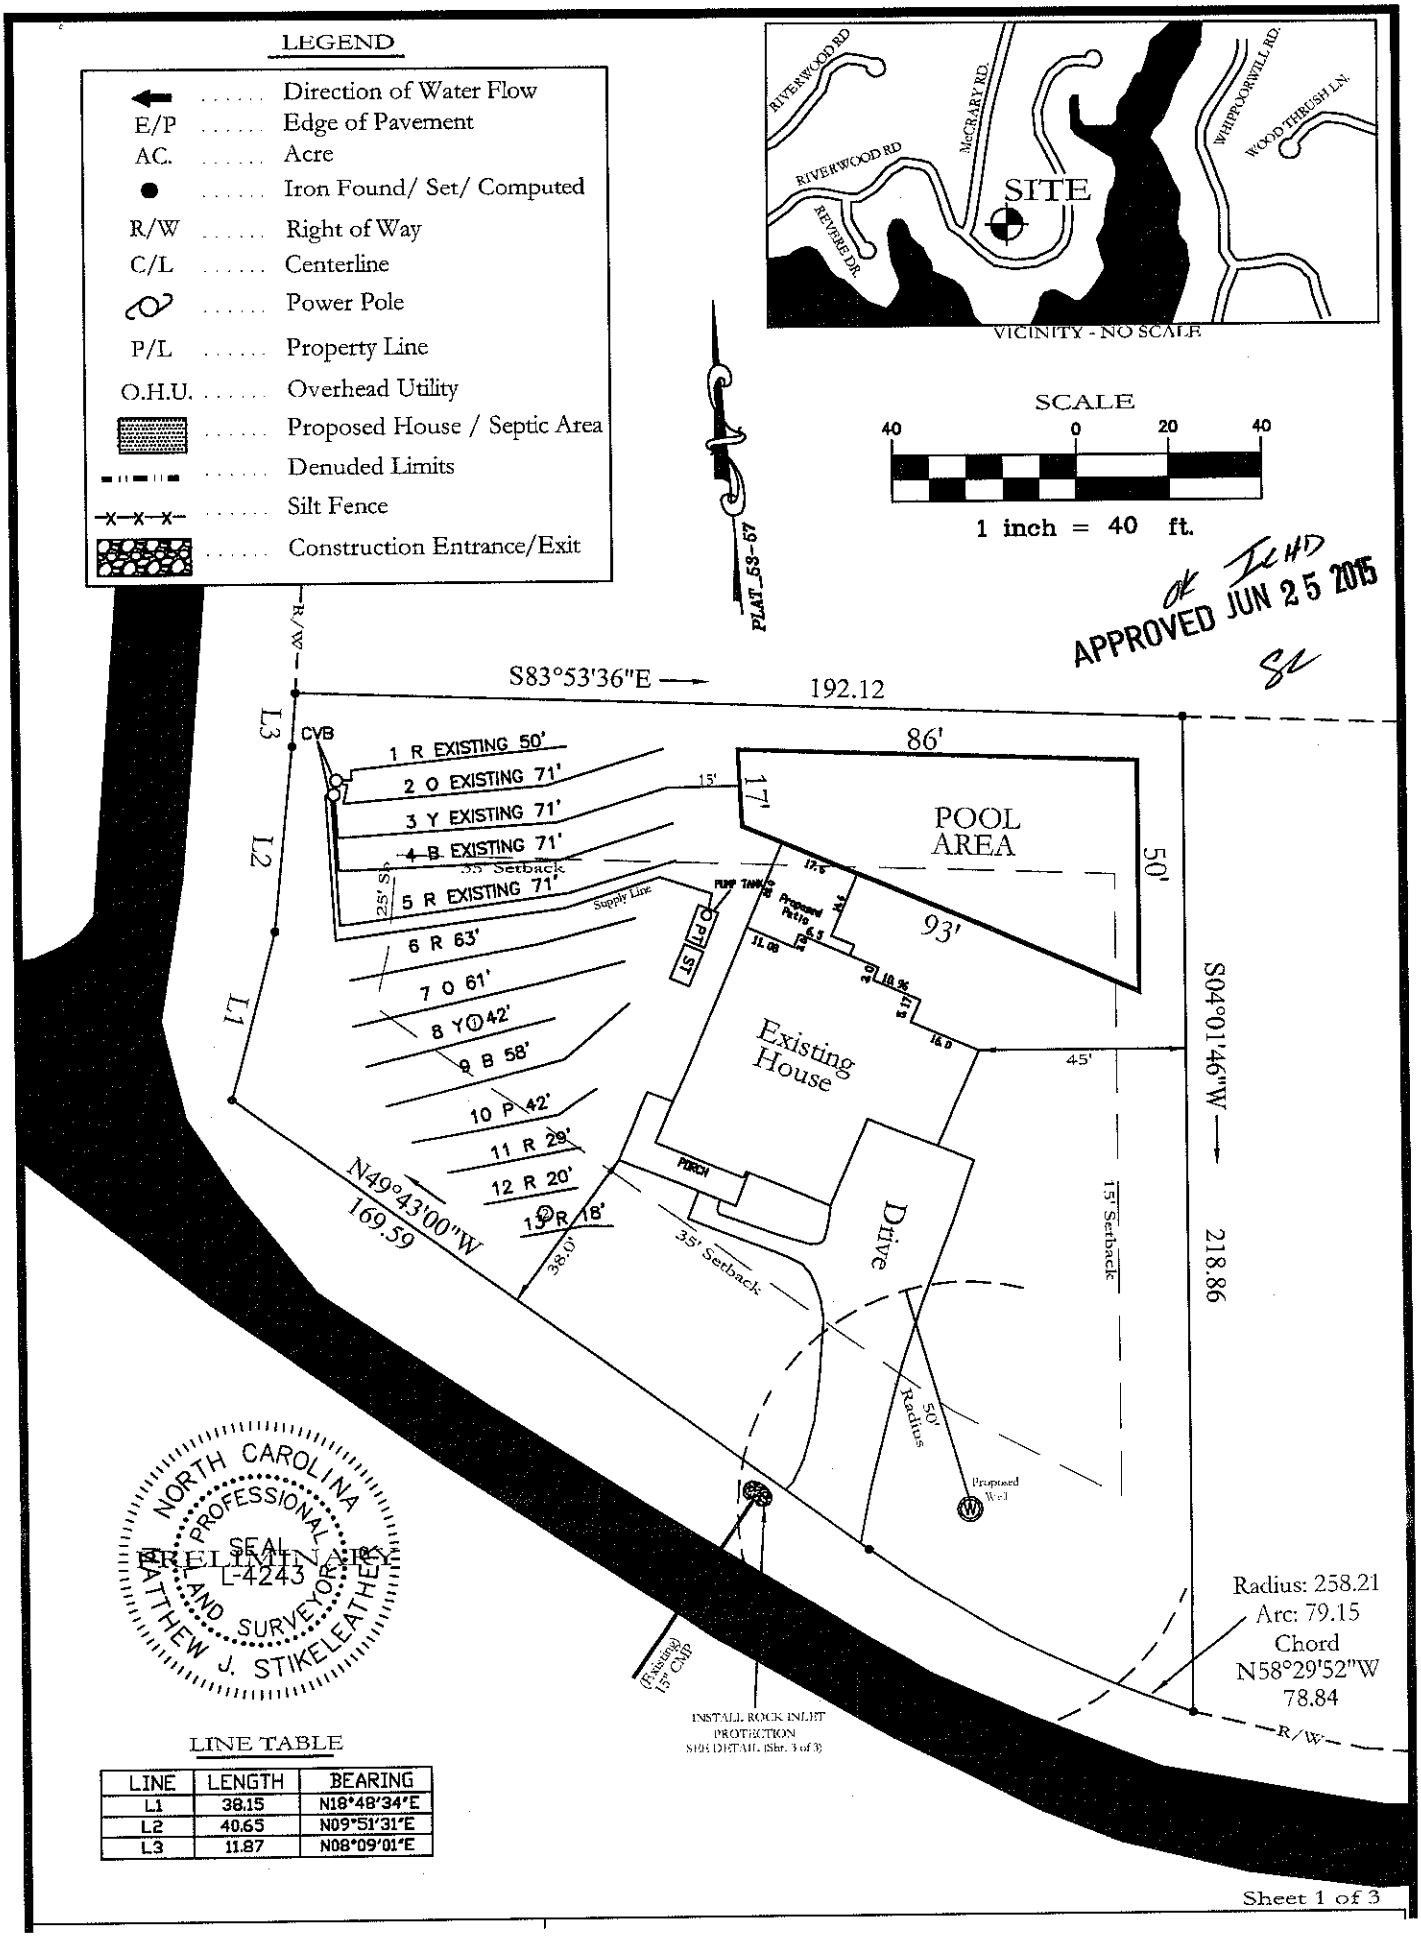

LINE TABLE

LINE	LENGTH	BEARING
L1	38.15	N18°48'34"E
L2	40.65	N09°51'31"E
L3	11.87	N08°09'01"E