IREDELL COUNTY HEALTH DEPARTMENT

STATESVILLE 704-878-5305 MOORESVILLE 704-664-5281

IMPROVEMENT PERMIT / AUTHORIZATION TO CONSTRUCT / OPERATION PERMIT / EXISTING SYSTEM INSPECTION

PERMIT# 119570 PIN# ~~4637-16-6115.017~~ 4637-15-1511 DATE 7/14/04

OWNER OR CONTRACTOR McCRARY PARTNERS/MidAtlantic PHONE: Business 799-9770 Home Contr 587-2141

ADDRESS PO BOX 3608 MOORESVILLE NC 28117

LOCATION 150 WEST - TL McCRARY - TR RIVERWOOD - ON RT

SUBDIVISION McCRARY WOODS BLOCK / SECTION 1 LOT ~~66~~ 11 LOT AREA .73Ac SITE CLASS PS DESIGN FLOW 450GPD L.T.A.R. .36 PD/KF 2

Septic Tank: 1000 Gallons; STB 794 Date 4-18-05
Pump Tank: ____ Gallons; PT ____ Date ____
Pump Make: ____ Model ____ Serial No. ____
Nitrification Field: No Fields 1 Square Feet 1200 Linear Feet 400
No Lines 5@80' Trench Width 36" Max Trench Bottom Depth 36" Gravel Depth ____

☑ New System ☐ Repair System Type: I, II, (III), IV, V, VI
System Description: GRAVITY 25% REDUCTION
Repair System Description: LP PANEL
Maintenance Agreement Required: ☐ Yes ☑ No


☑ House/Mod. Home No. Bedrooms 4
☐ Mobile Home No. Bathrooms 4
☐ Business No. Employees ____
☐ Other ____
☐ Slab ☑ Crawl Space ☐ Basement w/plumbing ☐ Basement wo/plumbing

Water Supply: ☑ Individual ☐ Public ☐ Community


Comments:/Conditions:

Comments:/Conditions: Installed EZ Flow in 6 lines @ 65' (parallel to House) ☆See Attached "As Built"

INITIAL SITE SKETCH 1"=50'

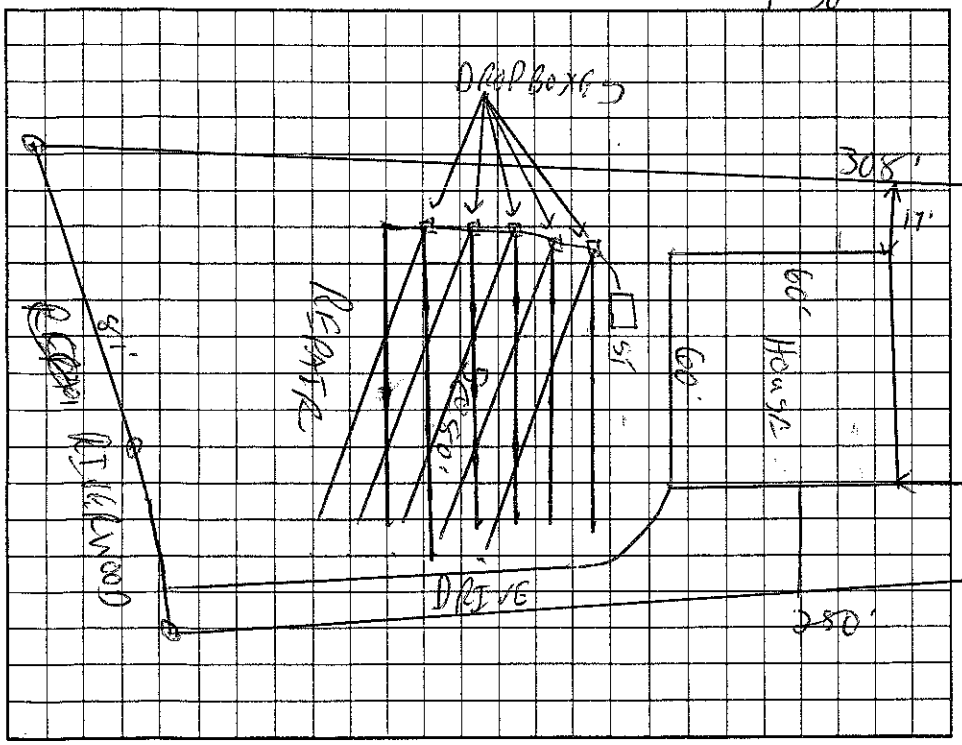

AS BUILT SKETCH

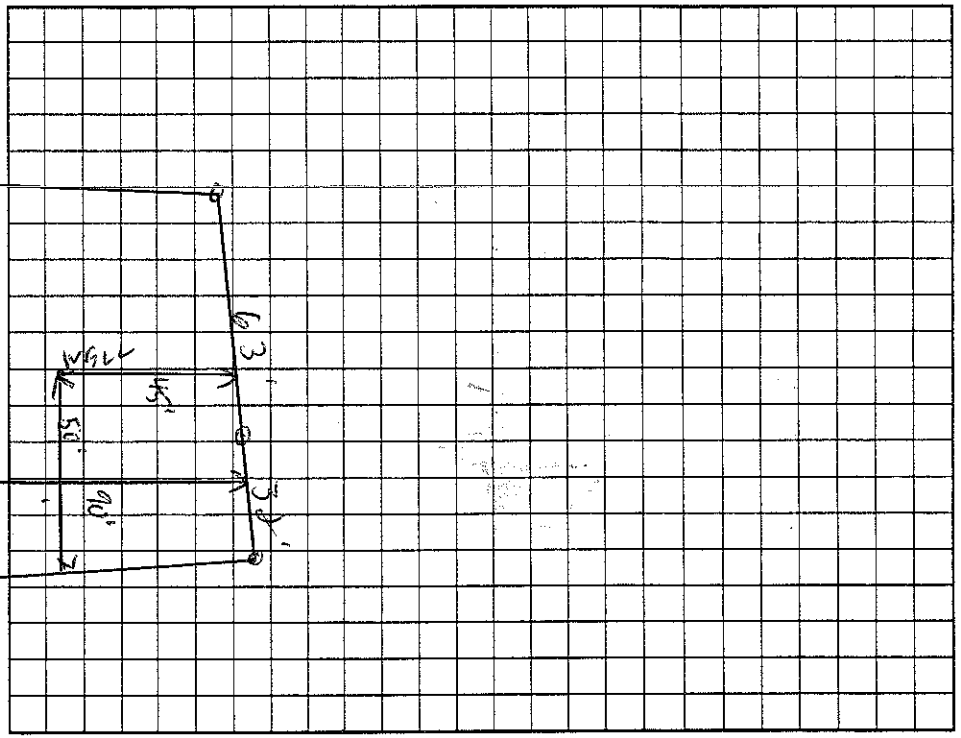

Permit can be suspended or revoked if any false information is supplied toward securing the permit/any unauthorized changes are made to the site/any unauthorized changes are made in the installation of the system. Improvement Permit with plat valid without ~~expiration~~. Improvement Permit with site plan valid for sixty months. Authorization to Construct is valid for a period equal to that of Improvement Permit – not to exceed sixty months.

Signed: ____ date 8-3-04 Installed by: Howard's Backhoe

Improvement Permit by: C. [illegible] RS date 7/14/04 Operation Permit by: Maria H. Dotson date 7/19/05

Authorization to Construct by: Maria H. Dotson RS date 12/30/04 Existing System Inspection by: ____ date ____

HEALTH DEPT. COPY: WHITE OWNER COPY (FINAL): YELLOW OWNER COPY (INITIAL): PINK

IREDELL COUNTY HEALTH DEPARTMENT

STATESVILLE 704-878-5305 MOORESVILLE 704-664-5281

As Built

IMPROVEMENT PERMIT / AUTHORIZATION TO CONSTRUCT / OPERATION PERMIT / EXISTING SYSTEM INSPECTION

PERMIT# 119570 PIN# 4637166015 DATE

OWNER OR CONTRACTOR Mid Atlantic PHONE: Business Home

ADDRESS

LOCATION

SUBDIVISION McCrary Woods BLOCK / SECTION LOT 17 LOT AREA SITE CLASS. DESIGN FLOW 480 L.T.A.R. .3

Septic Tank: 1500 Gallons: STB 794 Date 4-18-05

Pump Tank: Gallons; PT Date

Pump Make: Model Serial No.

Nitrification Field: No Fields 1 Square Feet 1170 Linear Feet 390

No Lines 6 @ 65 Trench Width 36" Max Trench Bottom Depth 36" Gravel Depth N/A

☒ New System ☐ Repair System Type: I, II, III, IV, V, VI

System Description: Gravity - 2570 Reduct

Repair System Description: LPP Panel

Maintenance Agreement Required: ☐ Yes ☒ No

☐ House/Mod. Home ☐ Mobile Home ☐ Business ☐ Other

No. Bedrooms 4 No. Bathrooms 4 No. Employees


☐ Slab ☐ Crawl Space ☐ Basement w/plumbing ☐ Basement wo/plumbing

Water Supply: ☒ Individual ☐ Public ☐ Community


Comments:/Conditions:

Comments:/Conditions:

INITIAL SITE SKETCH

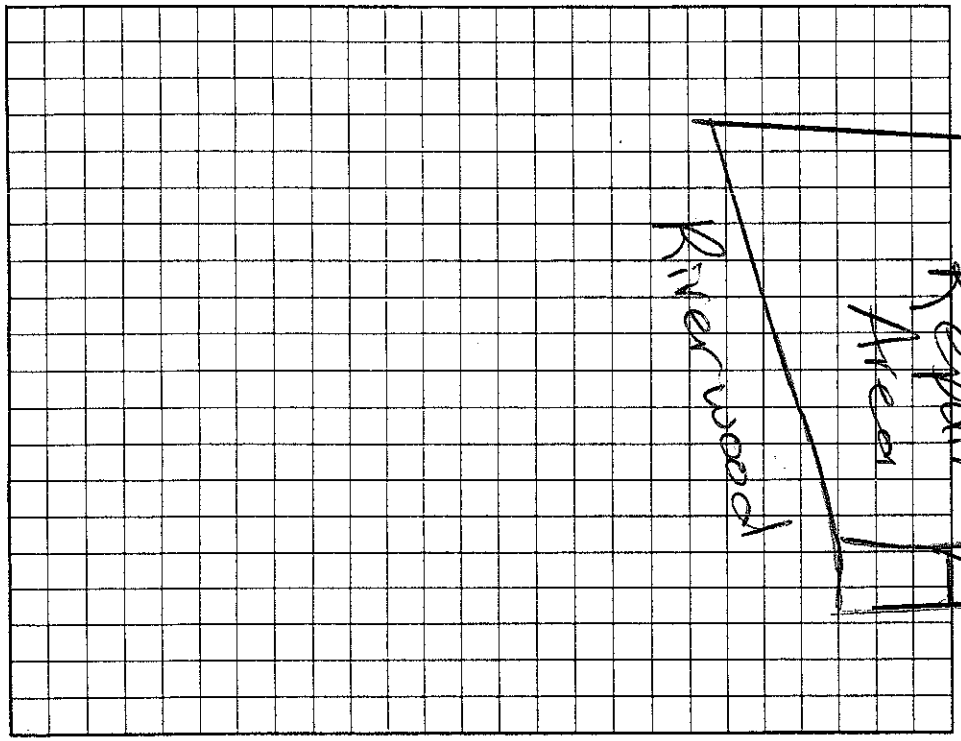

AS BUILT SKETCH

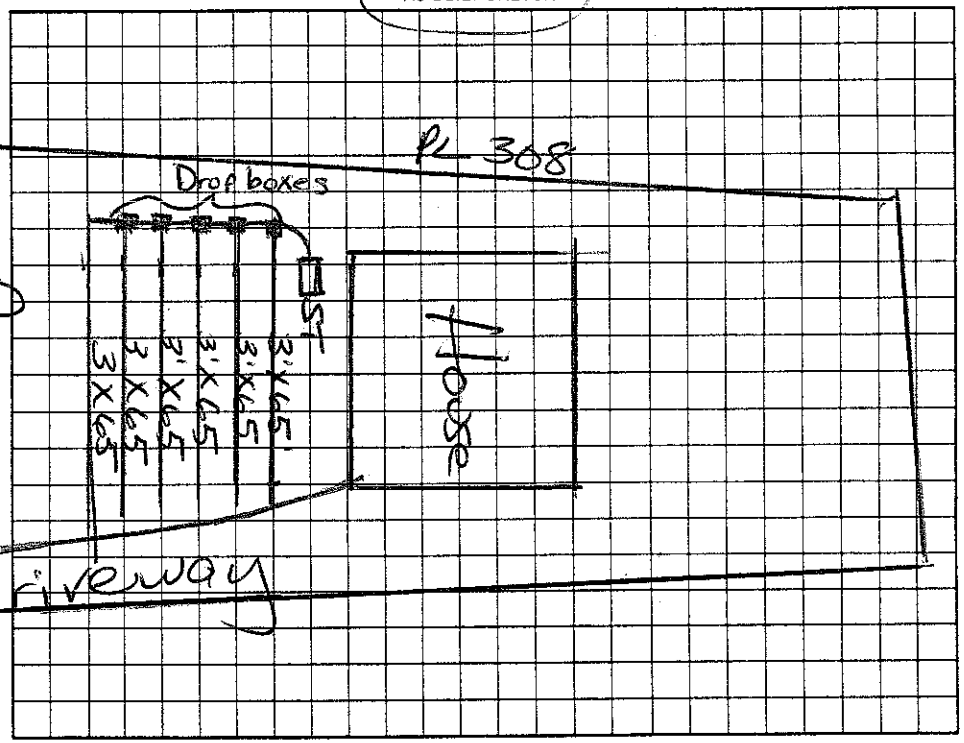

Permit can be suspended or revoked if any false information is supplied toward securing the permit/any unauthorized changes are made to the site/any unauthorized changes are made in the installation of the system. Improvement Permit with plat valid without expiration. Improvement Permit with site plan valid for sixty months. Authorization to Construct is valid for a period equal to that of Improvement Permit – not to exceed sixty months.

Signed: date

Improvement Permit by: date

Authorization to Construct by: date

Installed by: Howard's Backhoe

Operation Permit by: Maria H Edwards date 7/19/05

Existing System Inspection by: date

HEALTH DEPT. COPY: WHITE OWNER COPY (FINAL): YELLOW OWNER COPY (INITIAL): PINK