IREDELL COUNTY HEALTH DEPARTMENT

STATESVILLE 704-878-5305 MOORESVILLE 704-664-5281

IMPROVEMENT PERMIT / AUTHORIZATION TO CONSTRUCT / OPERATION PERMIT / EXISTING SYSTEM INSPECTION

PERMIT# 119571 PIN# 4637-16-6015-018 4637-15-2509 DATE 7/16/04

OWNER OR CONTRACTOR McCRARY PARTNERS / ANAHEIM HOMES PHONE: Business 799-9770 Home

ADDRESS B PO BOX 3608 MOORESVILLE NC 28117

LOCATION 150 WEST - TL McCRARY - TR RIVERWOOD - ON RT

SUBDIVISION McCRARY WOODS BLOCK / SECTION LOT 18 LOT AREA 1.79AC SITE CLASS. PS DESIGN FLOW 480GPD L.T.A.R. 1.36PO/AC

Septic Tank: 1000 Gallons; STB 1012 Date

Pump Tank: 1000 Gallons; PT 17 Date

Pump Make: Goulds Model WE5511H Serial No.

Nitrification Field: No Fields 1 Square Feet 1200 Linear Feet 400

No Lines 5 @ 80' Trench Width 36" Max Trench Bottom Depth 36" Gravel Depth N/A

☑ New System ☐ Repair System Type: I, II, III, IV, V, VI

System Description: PUMP 25% REDUCTION

Repair System Description: CP PANEL

Maintenance Agreement Required: ☐ Yes ☑ No

☑ House/Mod. Home No. Bedrooms 4

☐ Mobile Home No. Bathrooms 4

☐ Business No. Employees

☐ Other


☐ Slab ☑ Crawl Space ☐ Basement w/plumbing ☐ Basement wo/plumbing

Water Supply: ☑ Individual ☐ Public ☐ Community


Comments/Conditions: ~~X~~ DO NOT CUT HOUSE PAD ~~X~~

Comments/Conditions: "240 Riverwood Rd."

1"=50' INITIAL SITE SKETCH

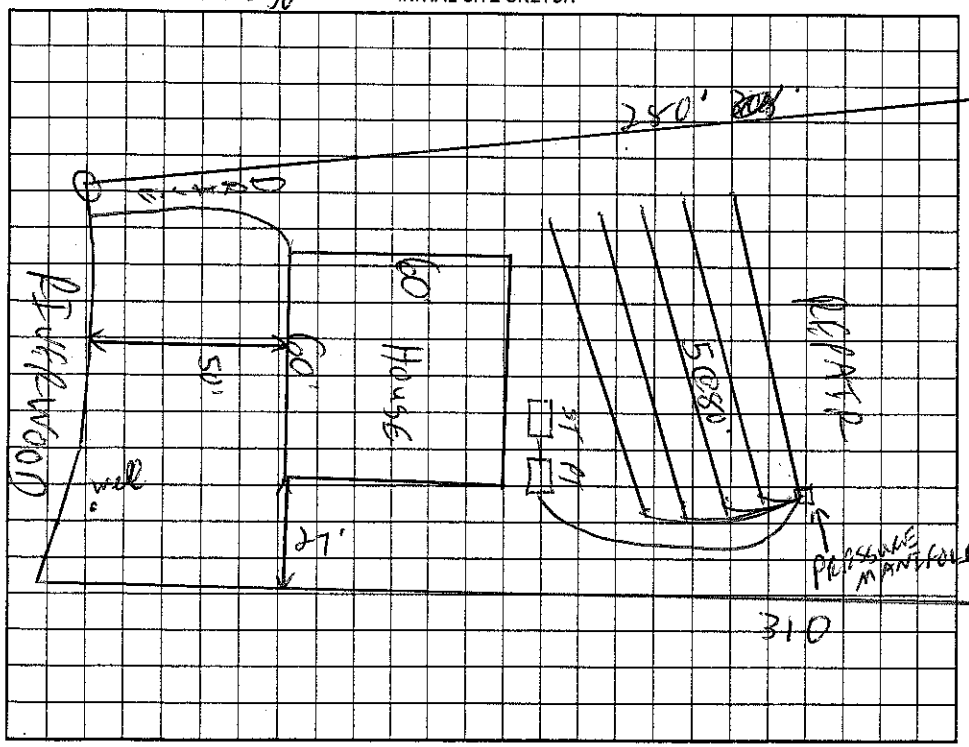

AS BUILT SKETCH

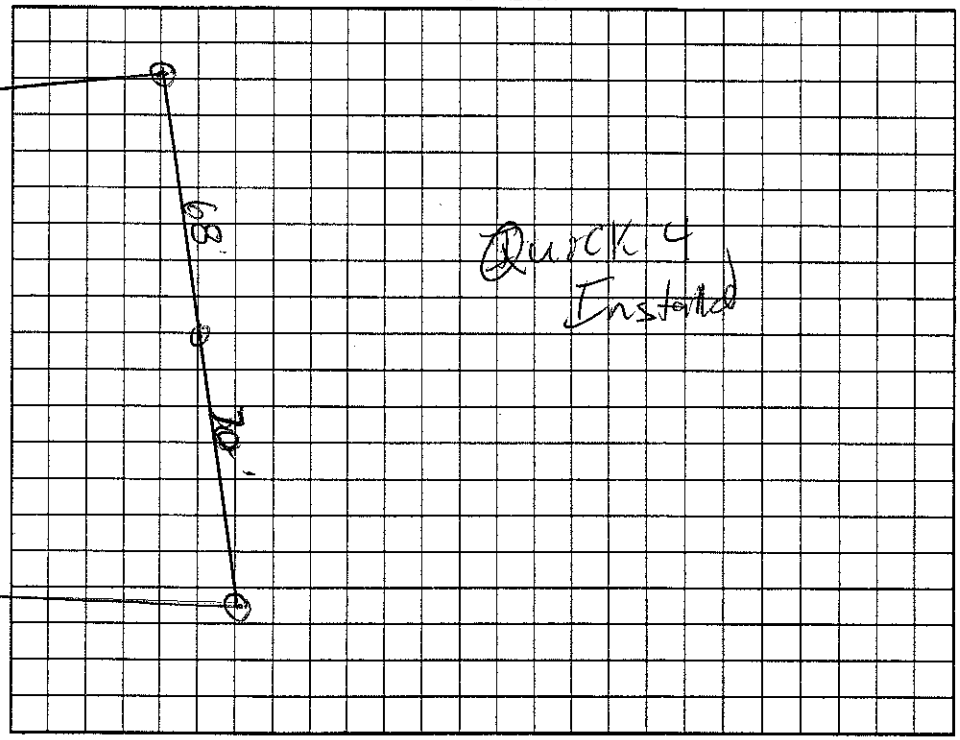

Permit can be suspended or revoked if any false information is supplied toward securing the permit/any unauthorized changes are made to the site/any unauthorized changes are made in the installation of the system. Improvement Permit with plat valid without expiration. Improvement Permit with site plan valid for sixty months. Authorization to Construct is valid for a period equal to that of Improvement Permit – not to exceed sixty months.

Signed: _____ date 8-3-04

Improvement Permit by: _____ date 7/16/04

Authorization to Construct by: _____ date 7/25/05

Installed by: _____

Operation Permit by: _____ date 5/18/06

Existing System Inspection by: _____ date _____

HEALTH DEPT. COPY: WHITE OWNER COPY (FINAL): YELLOW OWNER COPY (INITIAL): PINK